

TO ALL BIDDERS OF RECORD:

This Addendum forms a part of the Contract Documents and modifies the Drawings and Project Manual as hereinafter indicated.

1) BIDDER'S QUESTIONS

Q: Drawing E300 - Electric Riser Diagram: Riser Diagram Note #2 - Existing Panels "MDP" & "HP" Are Manufactured By FPE. These Two Panels Require New Circuit Breakers to Be Furnished & Installed by The E.C. New FPE Circuit Breakers Are Obsolete & Cannot Be Purchased. Refurbished Circuit Breakers Are Not Acceptable in Public Construction as All Items Are Required to Be New. To Avoid Conflict & Warranty Issues, New Circuit Breakers Would Need to Be OFCI - Owner Furnished Contractor installed Per Contract. Please Advise How to Proceed ASAP.

RISER DIAGRAM NOTES:

1. REFER TO ELECTRICAL SITE PLAN ON DRAWING ES100 FOR ADDITIONAL INFORMATION.
2. THE EXISTING ELECTRICAL SERVICE IS RATED 208Y/120V, 3-PHASE, 4-WIRE, 400-AMPS. THE EXISTING ELECTRIC MAIN SERVICE CIRCUIT BREAKER AND PANELBOARDS "MDP", "LP", "PP", AND "HP" ARE ALL MANUFACTURED BY FPE. ALL NEW CIRCUIT BREAKERS AND EQUIPMENT PROVIDED UNDER THIS CONTRACT SHALL BE 100% COMPATIBLE WITH THE EXISTING ELECTRICAL EQUIPMENT AND SHALL MATCH THE EXISTING AIC RATINGS.

RISER DIAGRAM KEYED NOTES:

- ① PROVIDE SURGE PROTECTIVE DEVICE LISTED FOR USE ON SERVICE ENTRANCE EQUAL TO DITEK #D200M-120/2083YT.
- ② PROVIDE (1) NEW 100A/3P CIRCUIT BREAKER AT EXISTING PANEL "MDP" TO SERVE NEW STORAGE BUILDING PANELBOARD "P1".
- ③ PROVIDE 4#250KCM, #4G IN 3"C. CONDUIT SHALL BE ROUTED THROUGH ATTIC SPACE. REFER TO ELECTRICAL SITE PLAN ON DRAWING ES100 FOR ADDITIONAL INFORMATION.
- ④ PROVIDE 4#2, #8G IN 2" SCHEDULE 40 PVC CONDUIT. REFER TO ELECTRICAL SITE PLAN ON DRAWING ES100 FOR ADDITIONAL INFORMATION.
- ⑤ PROVIDE (2) NEW 20A/1P GFCI CIRCUIT BREAKERS AT EXISTING PANEL "HP". REFER TO ELECTRICAL SITE PLAN ON DRAWING ES100 FOR ADDITIONAL INFORMATION.
- ⑥ PROVIDE (1) NEW 60A/3P CIRCUIT BREAKER AT EXISTING PANEL "MDP" TO SERVE NEW SURGE PROTECTIVE DEVICE. PROVIDE 4#6,#10G,1-1/4"C.

A: We were unable to find any state mandate stating that refurbished equipment is unacceptable for public construction projects. The electrical contractor shall provide a circuit breaker procurement and installation pending approval from the electrical inspector. Additionally, provide a spare for each refurbished equipment requested by the Owner.

Q: Drawing E300 Keyed Note 3 instructs us to run 4#250, #4G in 3"C across the attic of the existing building, but keyed note 4 shows this feeder than drops down in size to 4#2, #8G in 2" C from the existing building to the new building. Was the change in size intentional?

A: Keyed note #3 on drawing E300 shall be revised to read as follows: "PROVIDE 4#2, #8G IN 2"C. CONDUIT SHALL BE ROUTED THROUGH ATTIC SPACE. REFER TO THE ELECTRICAL SITE PLAN ON DRAWING ES100 FOR ADDITIONAL INFORMATION."

Q: Drawing E300 Riser Note 2 says new breakers and equipment to match the existing AIC rating. Please provide the existing AIC rating.

A: Electrical sub-contractor shall coordinate with the Utility Company for existing AIC rating.

Q:  Occupancy Sensors Illustrated on Drawing A600 Do Not Appear to Be In The Same Locations As Shown On Drawing E200. Please Clarify.

A: Install as shown on E200. Sheet A600 has been updated and reissued.

Q:  Smoke Detectors Illustrated on Drawing A600 Are Not Shown on Drawing E200. Please Clarify.

A: Smoke detectors are not required. Sheet A600 has been updated and reissued.

Q:  CO/NO2 Sensors Illustrated on Drawing A600 Are Not Shown on Drawing E200. Are These Sensors Part of the Gas Detection System to Be F&I By The Mechanical Sub-Contractor. Please Clarify.

A: Sensors are installed and wired by the mechanical contractor.

Q: Drawing A010 does show an FACP symbol, there is nothing about a Fire Alarm System on the electrical drawings. Should there be?

A: FACP is removed from sheet A010. Refer to reissued sheet A010.

Q: 08 33 10 and 08 36 00 are Sectional Overhead Doors Specs...which spec is being used? (Note: 08 33 00 lists only Overhead Door as an accepted manufacturer while 08 36 00 lists Wayne Dalton, but this spec is not included in the Table of Contents?).

A: Omit sections and refer to reissued section 08 36 00 SECTIONAL OVERHEAD DOORS.

Q: The glass specs are not clear as to what they want on the Sectional garage door (08 33 20). Its list out almost all potential options and does not select which option they would like. For example it lists every type of glass and every color etc. Can we get clarification on what they want in the specs.

A: Provide 1/2" tempered insulated glazing for door vision panels. Refer to reissued sections 08 36 00 SECTIONAL OVERHEAD DOORS and 08 80 00 GLASS AND GLAZING.

Q: Please provide details and confirm what the screened fence is that is called out to be installed on top of the retaining wall. Note also that there are no specifications in the Project Manual for the fencing scope.

A: Refer to Section 32 31 23 - VINYL FENCING AND GATES and updated civil details.

Q: What Bid Submission Forms are required for this project? Please clarify.

A: The following forms are to be submitted:

1. For General Construction Bids
 - a. Section 00 01 10 FORM FOR GENERAL BID (enclosed in this addendum)
 - b. AIA Document A305-2020 CONTRATOR QUALIFICATIONS and Exhibits A-E
 - c. AIA Document A310-2010 BID BOND FORM
 - d. Section 00 65 00 LETTER OF INTENT

- e. **Section 01 22 00 UNIT PRICES**
- f. **Certification stating that bidder can bond for 100% value of construction.**
- g. **Current DCAMM Certificate of Eligibility for General Building Construction**
- h. **A current, signed DCAMM Prime / General Contractor Update Statement**
- i. **Certificate of Insurance**

2. For Filed Sub-Bids

- a. **Section 00 41 10 BID FORM FOR SUB-BID**
- b. **AIA Document A305-2020 CONTRATOR QUALIFICATIONS and Exhibits A-E**
- c. **AIA Document A310-2010 BID BOND FORM**
- d. **Section 01 22 00 UNIT PRICES**
- e. **A current signed DCAMM Sub Bidder's Certificate of Eligibility**
- f. **A DCAMM Sub Bidder's Update Statement.**

See ShareFile link for bid documents and addenda, which may outline any other additional requirements.

Q: Please confirm sewer shown on plan (C002) is existing.

A: The sewer line shown on the plan is proposed. Refer to the updated civil drawing C002 DEMOLITION PLAN.

Q: Please confirm all limits of the parking lot that will receive new pavement full depth, patch pavement or mill and overlay. The plans only appear to show new pavement full depth at new building and along the front of the existing building.

A: Refer to reissued civil drawing C003 SITE LAYOUT PLAN indicating proposed resurfacing and new asphalt square footage takeoffs.

a. PROJECT MANUAL

- 1) In section 00 00 10 TABLE OF CONTENTS, add the following sections:
 1. After Section 00 04 30 BID BOND FORM add:

.....	AIA A310-2010	2
-------	---------------------	---
 3. After Section 32 17 23 PAVEMENT MARKINGS add:

32 31 23	VINYL FENCES AND GATES	4
----------------	------------------------------	---
- 2) In section 00 00 10 TABLE OF CONTENTS, change page number for the following sections:

00.04 10	FORM FOR GENERAL BID	2
08.33 20	OVERHEAD SECTIONAL DOORS	5
- 3) In the project manual the following sections have been issued:
 1. 00 04 30 BID BOND FORM - Issue Document AIA A310-2010 under this Section.
 3. 31 31 23 VINYL FENCES AND GATES
- 4) In the project manual, replace the following with the updated sections:
 1. 00 04 10 FORM FOR GENERAL BID
 2. 08 33 20 OVERHEAD SECTIONAL DOORS
- 1) Section 00 08 00 SUPPLEMENTARY CONDITIONS, add the following in Section 9.12 Liquidated Damages:
 - 9.12.2 The Contractor agrees to totally complete the project no later than March 28, 2025.
 - 9.12.3 The Contractor also agrees to totally complete (final completion) the project within 45 days after the date of substantial completion.

9.12.4 In the event that the project is uncompleted at the expiration of the contract time established, liquidated damages of \$500.00 per calendar day shall be assessed against the Contractor for each day in excess of the period of time allotted. An extension may be agreed upon between the Owner and Contractor.

2) Section 01 10 00 SUMMARY OF WORK, change items 1.4 WORK SEQUENCE to state the following:

A. Due to the limited space on the site and public accessibility, the Owner prioritizes the following site work improvements work areas to be completed in the following sequence. The contractor is responsible for coordinating the work phases with the Owner:

1. Front parking area to be open and available for public use
2. Rear parking area to maintain access to the existing maintenance garage for staff
3. Staff parking area (plan east)
4. Driveway (plan west)

Additionally in section 01 10 00 SUMMARY OF WORK, add the following to item 1.26 LIST OF DRAWINGS:

CIVIL - C008 DETAIL SHEET (1 OF 3)

LANDSCAPE - L2.0 LANDSCAPING DETAILS AND NOTES

3) Section 04 20 00 UNIT MASONRY (FILED SUB-BID), change items 2.3.A.1 and 2.3.A.2 (BRICK) to state the following:

1. Trade Reference and Color: Subject to compliance with requirements, basis of design as indicated:
 - a) Bowerston Shale Company (Hanover Plant) 1329 Seven Hills Rd NE, Newark, OH 43055, p: (740) 763-3921, e: info@bowerstonshale.com
 - b) Color: Bordeaux (Harbour Collection)
2. Size: Standard 3-5/8" W x 2-1/4" H x 7-5/8" L
3. Equivalent products by the following may be submitted for approval:
 - a) McAvoy Brick
 - b) Brampton Brick

4) Section 13 34 19 METAL BUILDING SYSTEMS, omit Item 2.5.J Linear Panels in its entirety.

3. DRAWINGS

1. Replace the following Civil Drawings with reissued drawings with addendum #2 dated 6/28/2024:

1. C001 PROJECT NOTES
2. C002 DEMOLITION PLAN
3. C003 SITE LAYOUT PLAN
4. C004 GRADING, DRAINAGE, AND UTILITY PLAN
5. C005 EROSION AND SEDIMENT CONTROL PLAN
6. C006 DETAIL SHEET (1 OF 3)
7. C007 DETAIL SHEET (1 OF 3)
8. C008 DETAIL SHEET (1 OF 3)

2. Replace the following Architectural Drawings with reissued drawings with addendum #2 dated 6/28/2024:

1. G001 ABBREVIATIONS SYMBOLS AND GENERAL NOTES
2. A010 CODE REVIEW
3. A100 FLOOR PLANS
4. A300 ENLARGED STAIR, ELEVATION AND SECTIONS

5. A400 BUILDING AND WALL SECTIONS
6. A600 REFLECTED CEILING PLANS
3. Replace Structural drawing S101 FOUNDATION PLAN AND MEZZANINE LEVEL FRAMING PLAN with the reissued sheet with addendum #2 dated 6/28/2024.
4. Replace the following Plumbing Drawings with reissued drawings with addendum #2 dated 6/28/2024:
 - a) P200 PLUMBING PLAN
 - b) P300 PLUMBING SITE PLAN
5. Replace the following Electrical Drawings with reissued drawings with addendum #2 dated 6/28/2024:
 - a) ES100 ELECTRICAL SITE PLAN
 - b) E300 ELECTRICAL RISER DIAGRAM

4. ATTACHMENTS

1. C001 PROJECT NOTES
2. C002 DEMOLITION PLAN
3. C003 SITE LAYOUT PLAN
4. C004 GRADING, DRAINAGE, AND UTILITY PLAN
5. C005 EROSION AND SEDIMENT CONTROL PLAN
6. C006 DETAIL SHEET (1 OF 3)
7. C007 DETAIL SHEET (1 OF 3)
8. C008 DETAIL SHEET (1 OF 3)
9. G001 ABBREVIATIONS SYMBOLS AND GENERAL NOTES
10. A010 CODE REVIEW
11. A100 FLOOR PLANS
12. A300 ENLARGED STAIR, ELEVATION AND SECTIONS
13. A400 BUILDING AND WALL SECTIONS
14. A600 REFLECTED CEILING PLANS
15. S101 FOUNDATION PLAN AND MEZZANINE LEVEL FRAMING PLAN
16. P200 PLUMBING PLAN
17. P300 PLUMBING SITE PLAN
18. ES100 ELECTRICAL SITE PLAN
19. E300 ELECTRICAL RISER DIAGRAM
20. 00 04 10 FORM FOR GENERAL BID
21. 00 04 30 BID BOND FORM - Issue Document AIA A310-2010 under this Section.
22. 08 33 20 OVERHEAD SECTIONAL DOORS
23. 31 31 23 VINYL FENCES AND GATES
24. Updated Plan holder's list

(THIS COMPLETES ADDENDUM NO. 2)



Drawn by L.J.G
Checked by PDC

Revised on ADDENDUM #2 - 6.28.2024

GENERAL NOTES:

1. LOT SHOWN IS DESIGNATED AS LOT 1 ON DEDHAM ASSESSORS MAP 14:8
2. ZONING DISTRICT: SINGLE RESIDENCE B
3. OWNER OF RECORD: - DEDHAM WESTWOOD WATER DISTRICT
50 ELM STREET
DEDHAM, MA 02026
BOOK 10454 PAGE 193
4. SITE IS NOT LOCATED IN FEMA FLOOD ZONE AS SHOWN ON FIRM PANEL 25021 C 0181 E EFFECTIVE ON JULY 17, 2012.
5. CONTRACTOR TO VERIFY LOCATION OF ALL UNDERGROUND UTILITIES PRIOR TO THE START OF CONSTRUCTION.

PLAN REFERENCE:

1. TOPOGRAPHIC PLAN OF LAND - 50 ELM STREET DEDHAM, MASSACHUSETTS; BY BRENNAN CONSULTING; DATED FEBRUARY 25, 2022.

DIMENSIONAL ZONING REQUIREMENTS:

RESIDENTIAL / AGRICULTURAL ZONING DISTRICT	
MINIMUM AREA	= 12,500 S.F.
MINIMUM FRONTAGE	= 95'
MINIMUM FRONT YARD SETBACK	= 25'
MINIMUM SIDE YARD SETBACK	= 15'
MINIMUM SIDE YARD SETBACK (1ST DET. ACCESSORY BLDG.)	= 5'
MINIMUM REAR YARD SETBACK	= 25'
MINIMUM REAR YARD SETBACK (1ST DET. ACCESSORY BLDG.)	= 5'
MAXIMUM HEIGHT	= 30 / 38'
MAXIMUM % BUILDING COVERAGE	= 30%

A.2

CONSTRUCTION PROCEDURES AND SEQUENCING

- THE CONTRACTOR SHALL ORGANIZE SITE CONSTRUCTION IN A MANNER WHICH WILL ENSURE THE IMMEDIATE STABILIZATION OF SURFACES. PERIMETER CONTROLS EQUAL APPROVED PROJECT LIMITS.
- PRIOR TO ANY CONSTRUCTION ON SITE, THE CONTRACTOR SHALL SETUP PRE-CONSTRUCTION MEETING WITH OWNER.
- PRIOR TO THE COMMENCEMENT OF CONSTRUCTION, A LINE STRAW WATTLES, WILL BE PLACED AT ALL CONSTRUCTION TOE OF SLOPES IN THE AREA OF ROADWAY, PONDS, LANDSCAPED AREAS, AND ALONG PERIMETER OF PROJECT LIMIT OF DISTURBANCE WHERE INDICATED ON PROJECT PLANS.
- RESERVE EROSION CONTROL DEVICES SHALL BE STOCKPILED ON SITE IN THE EVENT OF EMERGENCIES, AND SHALL BE LOCATED 100' FROM REGULATED WETLAND RESOURCE AREAS.
- THE CONTRACTOR SHALL MAKE ALL NECESSARY PROVISIONS FOR THE PROPER STORAGE AND/OR REMOVAL OF DEBRIS ON SITE TO AVOID UNNECESSARY ACCUMULATION ON SITE.
- DRAINAGE STRUCTURES SHALL BE CONSTRUCTED FROM DOWNTREAM UP AND CONSTRUCTION SHALL INCLUDE THE PLACEMENT OF STONE AT THE FLARED PIPE ENDS AND OUTLET STRUCTURE INLETS AND OUTLETS AS SHOWN ON PROJECT PLANS.
- IN STREAM CONTROLS SUCH AS HAY BALE CHECK DAMS SHALL BE ESTABLISHED PRIOR TO CONSTRUCTION IF NEEDED.

INFILTRATION SURFACE PROTECTION

TO PROTECT THE INFILTRATION SURFACES (BENEATH AND ADJACENT TO THE RECHARGE SYSTEMS) FROM DEGRADATION BY CONSTRUCTION ACTIVITIES INCLUDE:

1. PROVIDE DEEP ROTOTILLING OF VAIN FLOOR I WITH NO SUBSEQUENT TRAFFICKING ON SURFACE.
2. PREVENTION OF CONTAMINATION OF THE EXPOSED SUBGRADE BY CONSTRUCTION VEHICLES.
3. PREVENTION OF EXCESSIVE COMPACTION BY CONSTRUCTION VEHICLES.
4. PREVENTION OF THE DISCHARGE OF WATER FROM CONSTRUCTION DEWATERING ACTIVITIES INTO THESE FACILITIES.

CONSTRUCTION INSPECTION

THE ENGINEER SHALL BE CALLED ON SITE DURING THE CONSTRUCTION OF THE INFILTRATION BASIN.

THE ENGINEER SHALL BE ON SITE DURING THE CONSTRUCTION AND LAYOUT OF ALL OUTLET STRUCTURES.

THE ENGINEER SHALL PERFORM FREQUENT INSPECTION OF THE STORMWATER SYSTEM DURING CONSTRUCTION, WITH CLEANING AND MAINTENANCE AS WARRANTED. DURING ACTIVE CONSTRUCTION PERIODS, WEEKLY INSPECTION IS REQUIRED.

IF CONSTRUCTION IS SUSPENDED (E.G., OVER THE WINTER), THEN MONTHLY INSPECTIONS ARE REQUIRED. IN ADDITION, THE SYSTEM SHOULD BE CHECKED AFTER ANY SIGNIFICANT RAINFALL, TO INSURE IT IS FUNCTIONING CORRECTLY AND TO MONITOR SEDIMENT ACCUMULATION FROM THE DISTURBED AREAS OF THE SITE.

ROUGH GRADING

DURING GRADING, THE POTENTIAL FOR EROSION IS HIGH. DURING GRADING OPERATIONS, DISTURBED SLOPES WILL BE MULCHED AND VEGETATION ESTABLISHED TO PREVENT SEDIMENT EROSION TO THE SATISFACTION OF THE ENGINEER.

OPERATION & MAINTENANCE PLAN NOTES:

THE MAINTENANCE AND UPKEEP ON THE EXISTING ROADWAY WILL INCLUDE THE FOLLOWING ELEMENTS:

CONSTRUCTION VEHICLES SHALL BE LIMITED TO ONE ACCESS POINT ON EACH LOT WHERE A CRUSHED-STONE CONSTRUCTION PAD ENTRANCE SHALL BE INSTALLED IN THE AREA OF THE PERMANENT DRIVEWAY TO ENSURE THAT MUD AND DEBRIS ARE NOT TRACKED ONTO THE ROADWAY. IF MUD IS INADVERTENTLY TRACKED ONTO THE ROAD, IT SHOULD BE REMOVED PROMPTLY.

GENERAL MAINTENANCE OF EROSION CONTROL ELEMENTS INCLUDING REGRADING, REVEGETATION, REPLACING RIPRAP, ETC., ON AN AS NEEDED BASIS.

A.2
INFILTRATION FACILITY AND CATCH BASINS WILL BE INSPECTED SEMI-ANNUALLY BY THE OWNER AND WILL BE MAINTAINED AS REQUIRED.

BUILD UP OF SEDIMENTATION AND DEBRIS SHALL BE MONITORED AND REMOVED ON A SEMI-ANNUALLY BASIS IN ORDER TO KEEP THE DISCHARGES AND FLOWS INTO THE INFILTRATION FACILITY FUNCTIONING PROPERLY.

ALL STORMWATER MANAGEMENT SYSTEMS MUST HAVE AN OPERATION AND MAINTENANCE PLAN TO ENSURE THAT SYSTEMS FUNCTION AS DESIGNED.

THE OWNER WILL BE RESPONSIBLE FOR THE OPERATION AND MAINTENANCE OF THE STORMWATER MANAGEMENT SYSTEM AND ALL OF ITS APPURTENANCES. THE FOLLOWING MAINTENANCE PROGRAM SHALL BE IMPLEMENTED:

A. CATCH BASIN INLETS

1. THE CATCH BASINS SHALL BE INSPECTED MONTHLY TO ASSURE THEY ARE FUNCTIONING PROPERLY, AND CLEANED BY REMOVING SEDIMENT AND DEBRIS, FOUR TIMES PER YEAR. CLEANING SHALL BE PERFORMED BY USE OF A VACUUM TRUCK OR OTHER METHOD AS RECOMMENDED BY THE CATCH BASIN MANUFACTURER.
2. ALL SEDIMENT AND HYDROCARBONS (PETROLEUM PRODUCTS) SHALL BE PREPARED, HANDLED AND DISPOSED IN ACCORDANCE WITH APPLICABLE GUIDELINES.
3. ALL DRAINAGE SYSTEM OUTLETS SHALL ALSO BE INSPECTED FOR DEBRIS AND MAINTAINED ACCORDINGLY. INSPECTION AND MAINTENANCE SHALL OCCUR IN MAY AND DECEMBER OF EACH YEAR.
4. ALL INSPECTIONS AND MAINTENANCE SHALL BE PERFORMED BY QUALIFIED INDIVIDUALS. RECORDS OF THE INSPECTIONS AND MAINTENANCE SHALL BE KEPT FOR A PERIOD OF FIVE (5) YEARS AND SHALL BE MADE AVAILABLE UPON REQUEST.

B. UNDERGROUND INFILTRATION SYSTEM

1. THE INFILTRATION SYSTEMS SHALL BE INSPECTED AT LEAST EVERY SIX MONTHS AND AFTER EVERY MAJOR STORM DURING THE FIRST YEAR TO ASSURE THEY ARE FUNCTIONING PROPERLY.
2. ANY NECESSARY REPAIRS SHOULD BE MADE IMMEDIATELY.
3. CLEANING SHALL BE PERFORMED BY USE OF A VACUUM TRUCK OR OTHER METHOD AS RECOMMENDED BY THE PIPING MANUFACTURE.
4. ALL DRAINAGE SYSTEM OUTLETS SHALL ALSO BE INSPECTED FOR DEBRIS AND MAINTAINED ACCORDINGLY. INSPECTION AND MAINTENANCE SHALL OCCUR IN MAY AND DECEMBER OF EACH YEAR.
5. IF THE INFILTRATION FACILITY FAILS TO DRAIN WITHIN 72 HOURS THEN A QUALIFIED PROFESSIONAL SHOULD ACCESS THE DEVICES AND PROVIDE RECOMMENDATIONS FOR CORRECTIVE ACTIONS, AND THE OWNER SHOULD TAKE IMMEDIATE ACTION TO IMPLEMENT THESE RECOMMENDATIONS TO RESTORE THE INFILTRATION FUNCTION.
6. ALL INSPECTIONS AND MAINTENANCE SHALL BE PERFORMED BY QUALIFIED INDIVIDUALS. RECORDS OF THE INSPECTIONS AND MAINTENANCE SHALL BE KEPT FOR A PERIOD OF FIVE (5) YEARS AND SHALL BE MADE AVAILABLE UPON REQUEST.

THE OWNER SHALL KEEP A WRITTEN RECORD OF INSPECTION DATES AND FINDINGS, PARTICULARLY CONCERNING THE INFILTRATION SYSTEM. A MAINTENANCE CHECKLIST SHALL BE USED IN THE SPECIFIED INSPECTIONS. RECORDS OF INSPECTIONS AND MAINTENANCE SHALL BE KEPT FOR AT LEAST THREE YEARS, AND AVAILABLE ON REASONABLE NOTICE FOR INSPECTION BY THE APPROPRIATE TOWN AGENCY.

EROSION & SEDIMENT CONTROL NOTES:

1. EROSION AND SEDIMENT CONTROL MEASURES WILL BE INSTALLED PRIOR TO THE START OF CONSTRUCTION. GRAVEL CONSTRUCTION ENTRANCE WILL BE INSTALLED BEFORE CONSTRUCTION TRAFFIC INTO AND OUT OF PROJECT AREA BEGINS. STABILIZATION OF ALL REGRADED AND SOIL STOCKPILE AREAS WILL BE INITIATED AND MAINTAINED DURING ALL PHASES OF CONSTRUCTION.

2. ALL EROSION AND SEDIMENT CONTROL MEASURES WILL BE CONSTRUCTED IN ACCORDANCE WITH THE LOCAL MUNICIPALITIES REGULATIONS. ALL EROSION CONTROL MEASURES ARE TO BE MAINTAINED AND UPGRADED AS REQUIRED TO ACHIEVE PROPER SEDIMENT CONTROL DURING CONSTRUCTION.

3. ADDITIONAL CONTROL MEASURES WILL BE INSTALLED DURING CONSTRUCTION PERIOD, IF DEEMED NECESSARY BY THE ENGINEER OR TOWN AGENCIES.

4. THE CONTRACTOR SHALL BE REQUIRED TO MAINTAIN EROSION AND SEDIMENT CONTROLS DURING CONSTRUCTION. ADDITIONAL MEASURES WILL BE REQUIRED TO PREVENT SEDIMENT DISCHARGE INTO THE STREET, AND DRAINAGE SYSTEMS.

5. SEEDING MIXTURE FOR FINISHED GRASSED AREAS WILL BE AS FOLLOWS:

KENTUCKY BLUE GRASS = 45%
CREAM COLOR FESCUE = 30%
PERENNIAL RYE GRASS = 10%
SEED TO APPLIED AT A RATE OF 4 LBS / 1000 S.F. FERTILIZER SHALL BE APPLIED AT A RATE OF 2 LBS / 1000 S.F. PLANTING SEASON SHALL BE APRIL 1 TO OCTOBER 15. AFTER OCTOBER 15 AREAS NOT SEDED SHALL BE STABILIZED WITH STRAW WATTLES, HAY BALE CHECK DAMS, FILTER FABRIC OR WOODEN MULCH AS REQUIRED TO CONTROL EROSION.

6. AREAS LEFT BARE BEFORE FINISH GRADING AND SEEDING IS ACHIEVED, SHALL RECEIVE A TEMPORARY SEEDING OF PERENNIAL RYE GRASS APPLIED TO A RATE OF 2 LBS / 1000 S.F. AT A DEPTH OF 1/2". LIMESTONE (EQUIVALENT TO BE 50 % CALCIUM PLUS MAGNESIUM OXIDE) SHALL BE APPLIED AS SEDED PREPARATION AT A RATE OF 120 LBS / 1000 S.F., WHERE GRASS PREDOMINATES, FERTILIZE ACCORDING TO A SOIL TEST AT A MINIMUM APPLICATION RATE OF 1 LB OF NITROGEN PER 1000 S.F. AREAS TO BE LEFT BARE BEFORE FINISH GRADING AND SEEDING OUTSIDE OF PLANTING SEASONS SHALL RECEIVE AN AIR-DRIED WOOD CHIP MULCH, FREE OF COURSE MATTER, TREATED WITH 12 LBS NITROGEN PER TON, APPLIED AT A RATE OF 185-275 LBS / 1000 S.F.

7. CONTRACTOR SHALL BE ASSIGNED THE RESPONSIBILITY FOR IMPLEMENTING THIS EROSION AND SEDIMENT CONTROL PLAN. THIS RESPONSIBILITY INCLUDES THE INSTALLATION AND MAINTENANCE CONTROL MEASURES, INFORM ALL PARTIES ENGAGED ON THE CONSTRUCTION SITE OF THE REQUIREMENTS AND OBJECTIVES OF THE PLAN, AND NOTIFY THE PROPER TOWN AGENCY OF ANY TRANSFER OF THIS RESPONSIBILITY. THE OWNER SHALL BE RESPONSIBLY FOR CONVEYING A COPY OF THE EROSION AND SEDIMENT CONTROL PLAN IF THE TITLE TO THE LAND IS TRANSFERRED.

8. THE CONTRACTOR SHALL REQUEST THE APPROPRIATE TOWNS AGENCIES TO INSPECT AND APPROVE THE INSTALLATION OF ALL EROSION CONTROL MEASURES PRIOR TO THE START OF CONSTRUCTION. PERIODIC INSPECTIONS OF EROSION CONTROL MEASURES MAY BE PERFORMED BY THE AGENCIES. THE CONTRACTOR SHALL REPAIR, UPGRADE OR REPAIR AND MEASURE THE USE OF THE AGENCIES MAY FEEL ARE IN NEED OF SUCH.

9. STOCKPILES OF SOIL SHALL BE SURROUNDED BY A SEDIMENT BARRIER. SOIL STOCKPILES TO BE LEFT BARE FOR MORE THAN FIFTEEN (15) DAYS SHALL BE STABILIZED WITH TEMPORARY VEGETATION OR MULCH, IF STOCKPILES ARE TO REMAIN FOR MORE THAN SIXTY (60) DAYS, FILTER FABRIC SHALL BE USED IN PLACE OF HAY BALES. SIDE SLOPES SHALL NOT EXCEED 2:1.

10. THE CONTRACTOR SHALL BE RESPONSIBLE TO CONTROL DUST AND WIND EROSION THROUGHOUT THE LIFE OF HIS CONTRACT. DUST CONTROL SHALL INCLUDE BUT NOT LIMITED TO SPRINKLING WATER ON EXPOSED SOILS AND HAUL ROADS. CONTRACTOR SHALL CONTROL DUST TO PREVENT A HAZARD TO TRAFFIC ON ADJACENT ROADWAYS.

11. SEDIMENT SHALL BE REMOVED ONCE THE VOLUME REACHES 1/4 TO 1/2 THE HEIGHT OF THE SILT FENCE OR HAY BALE, OR SILT SOCK.

12. ALL STOCKPILES SHALL BE SURROUNDED BY SEDIMENT CONTROLS.

13. DISTURBED AREAS REMAINING IDLE FOR MORE THAN 14 DAYS SHALL BE STABILIZED.

14. ALL FACILITIES USED AS TEMPORARY MEASURES SHALL BE CLEANED PRIOR TO BEING PUT INTO FINAL OPERATION.

15. PER THE MA DEP, BMP'S ARE NOT TO BE USED FOR TEMPORARY STORMWATER RUNOFF COLLECTION DURING THE PROJECTS CONSTRUCTION.

OBSERVATION TEST HOLE TH1

DEPTH	HORIZON	TEXTURE	COLOR	REDOX	OTHER
0"- 48"	FILL/HTM	-	-	-	g-gravel, c-cobbles, s-stone, b-boulders
48"- 60"	bAp	gls	10YR3/2	-	mix, sandy loam, loamy sand, g, c, s, b, loose
60"- 72"	bBw	gls	10YR5/8	-	p-plowed, gls, gravelly loamy sand, c, loose
72"- 144"	bC	gls	10YR7/2	-	gls, c, loose

GWT OBSERVATIONS: NO STANDING / NO WEEPING DATE: 2-9-2024

ESTIMATED SEASONAL HIGH WATER: > 144" BY: MICHAEL S. FARIA

BY: MICHAEL S. FARIA

DATE: 2-9-2024

ESTIMATED SEASONAL HIGH WATER: > 144"

BY: MICHAEL S. FARIA

DATE: 2-9-2024

ESTIMATED SEASONAL HIGH WATER: > 144"

BY: MICHAEL S. FARIA

DATE: 2-9-20




Drawn by L.J.G.
Checked by P.D.C.
Revised on ADDENDUM #2 - 6.28.2024

IN SITE Engineering Services, LLC
Professional Engineers Land Surveyors
Precision. Clarity. Certainty.
InSite Professional Complex, Suite 1
1539 Fall River Avenue Seekonk, MA 02771
Phone: (508) 336-4500 Fax: (508) 336-4558
Web Address: InsiteEngineers.com

50 Holden Street
Providence, Rhode Island 02908
Phone: (401) 272-1730
Fax: (401) 273-156
E-mail: rgbinfo@rgb.net
www.rgbs.net
Architecture • Project Management • Interior Design

Project
**DEDHAM-
WESTWOOD
WATER DISTRICT**

**STORAGE
FACILITY**

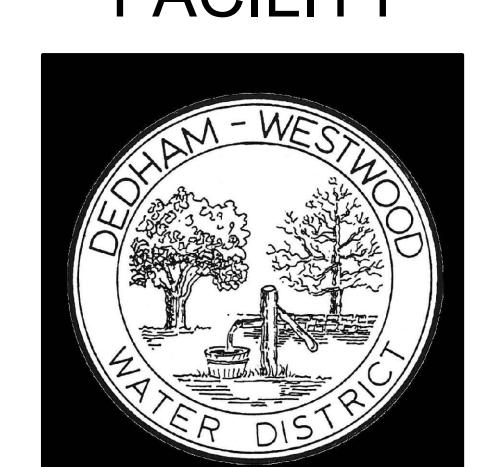

50 ELM STREET
DEDHAM, MA 02026


Drawing Status
**100% CONSTRUCTION
DOCUMENTS**

Issued On 6/28/2024

Sheet Contents
**SITE LAYOUT
PLAN**


Project Number. 6790
Drawing No. C003

Sheet 3 of 8

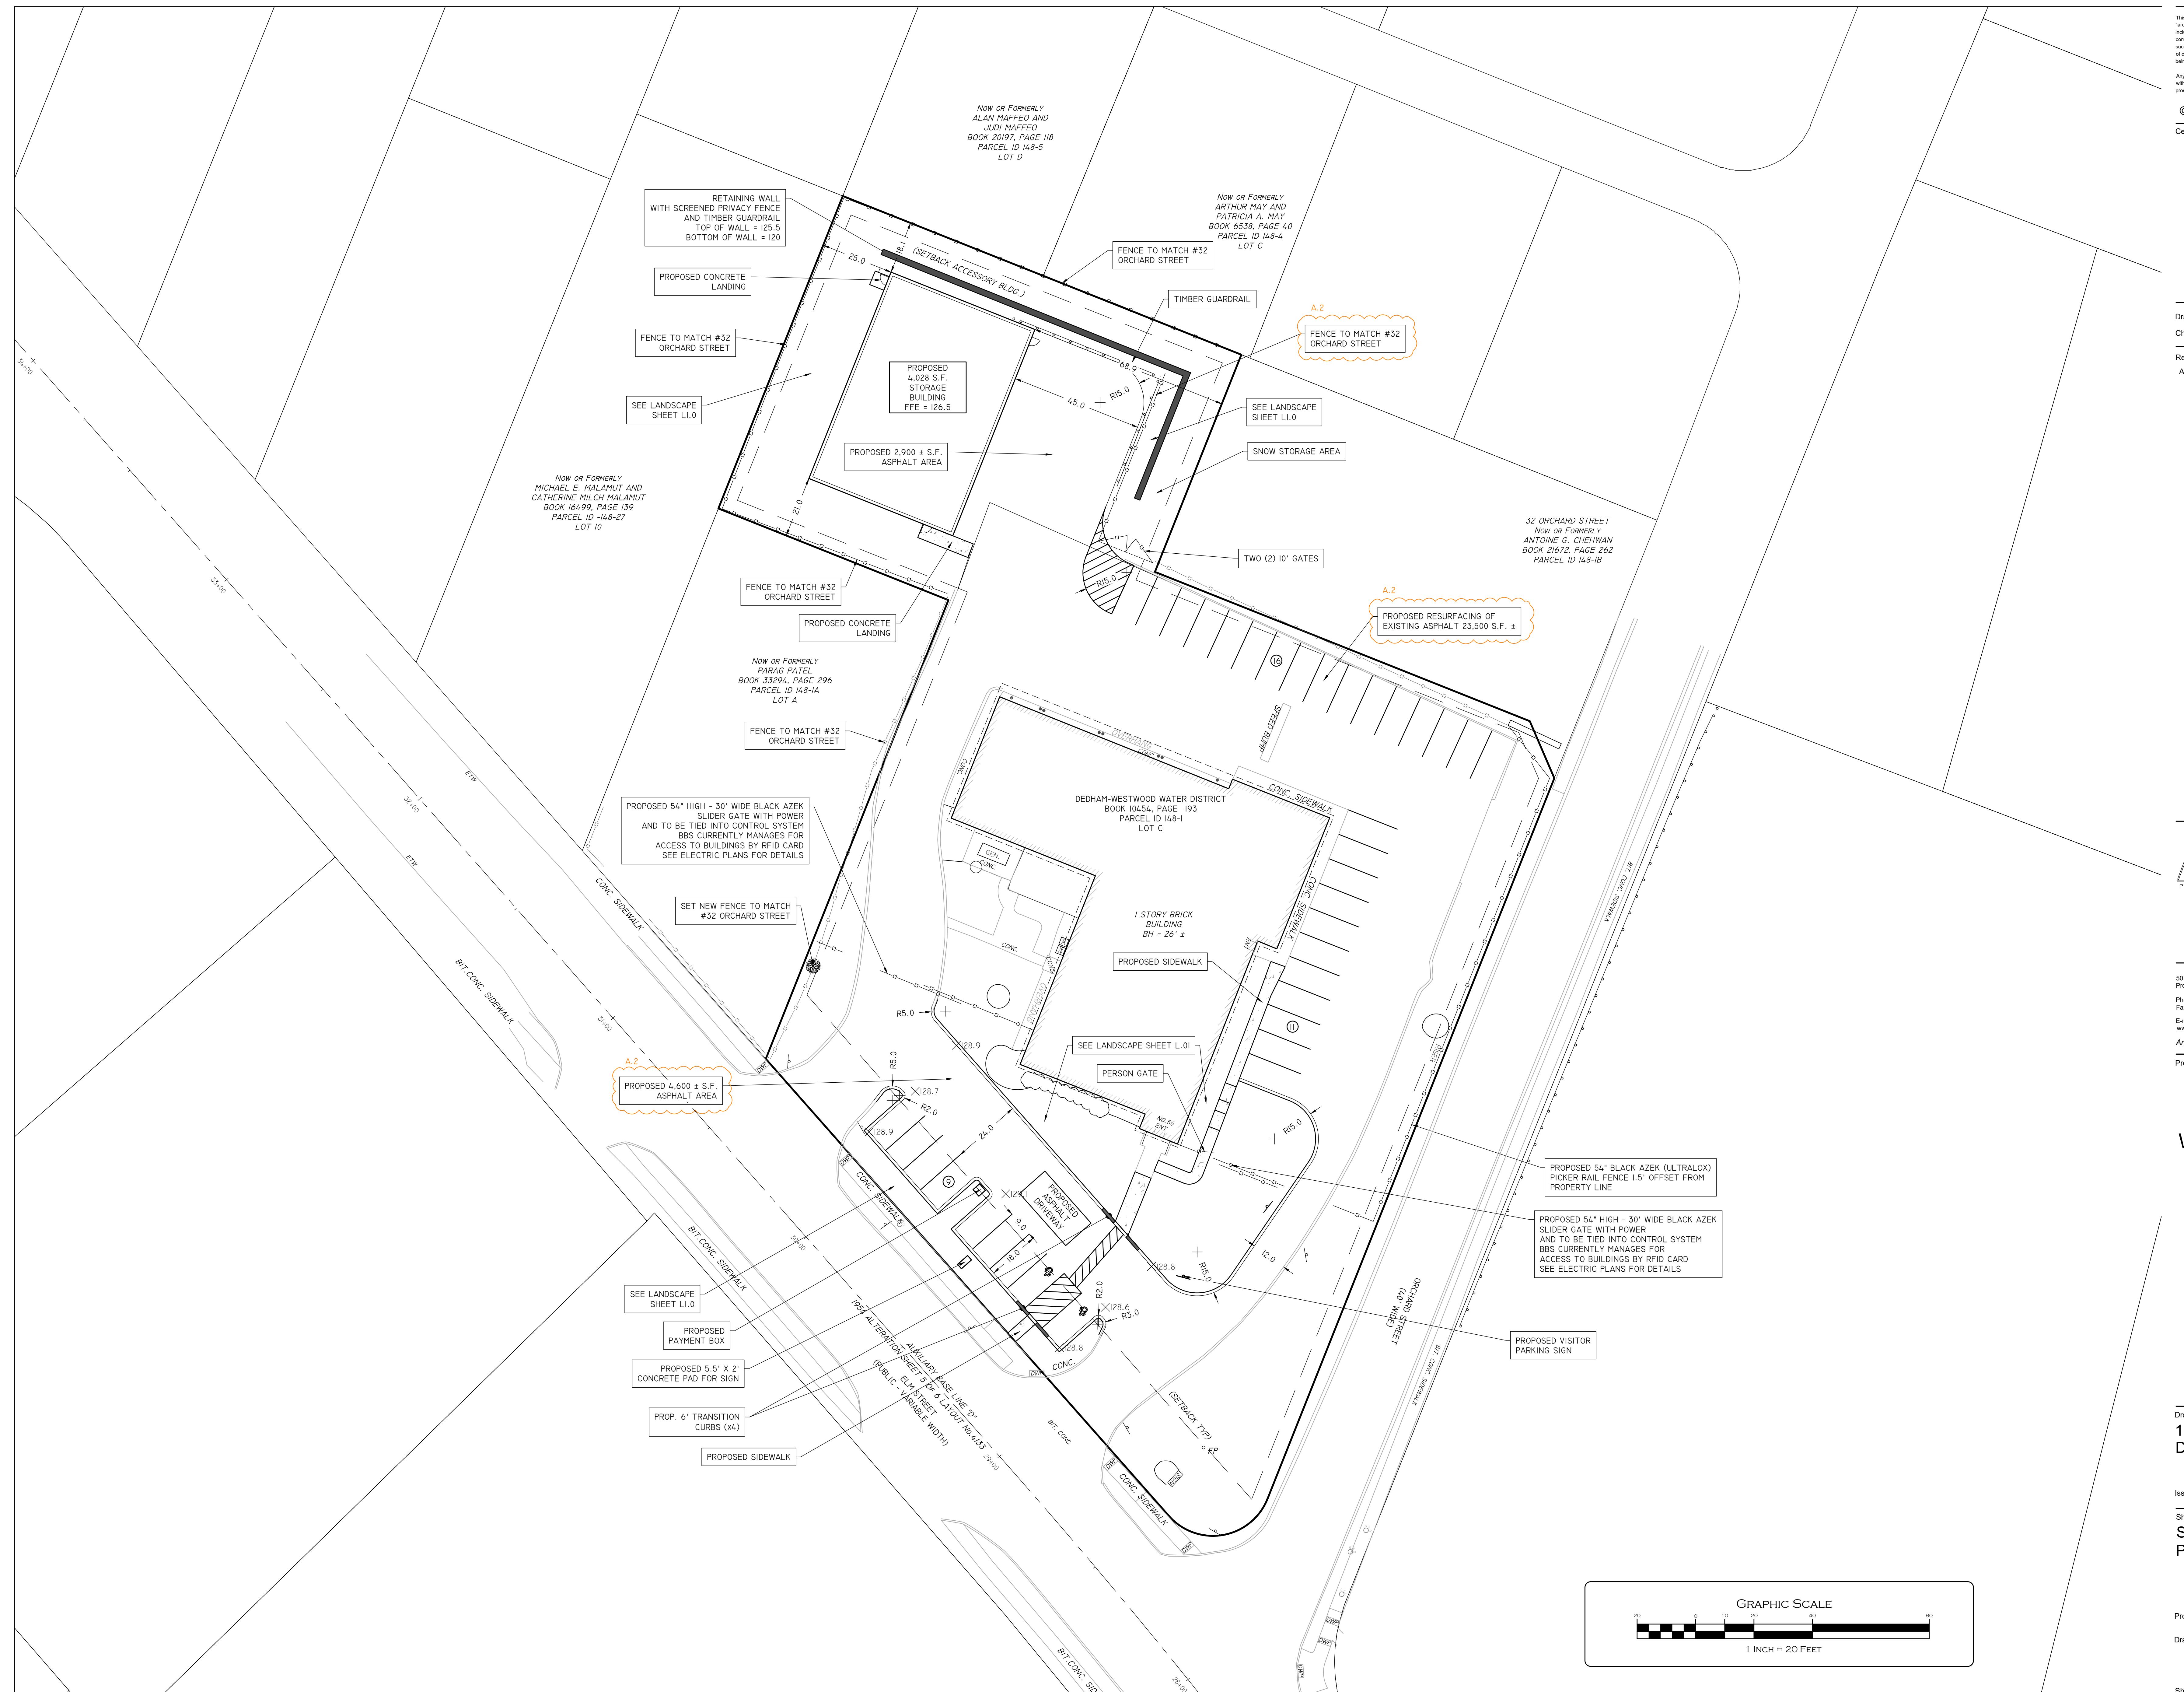



Drawn by L.J.G.
Checked by P.D.C.
Revised on ADDENDUM #2 - 6.28.2024

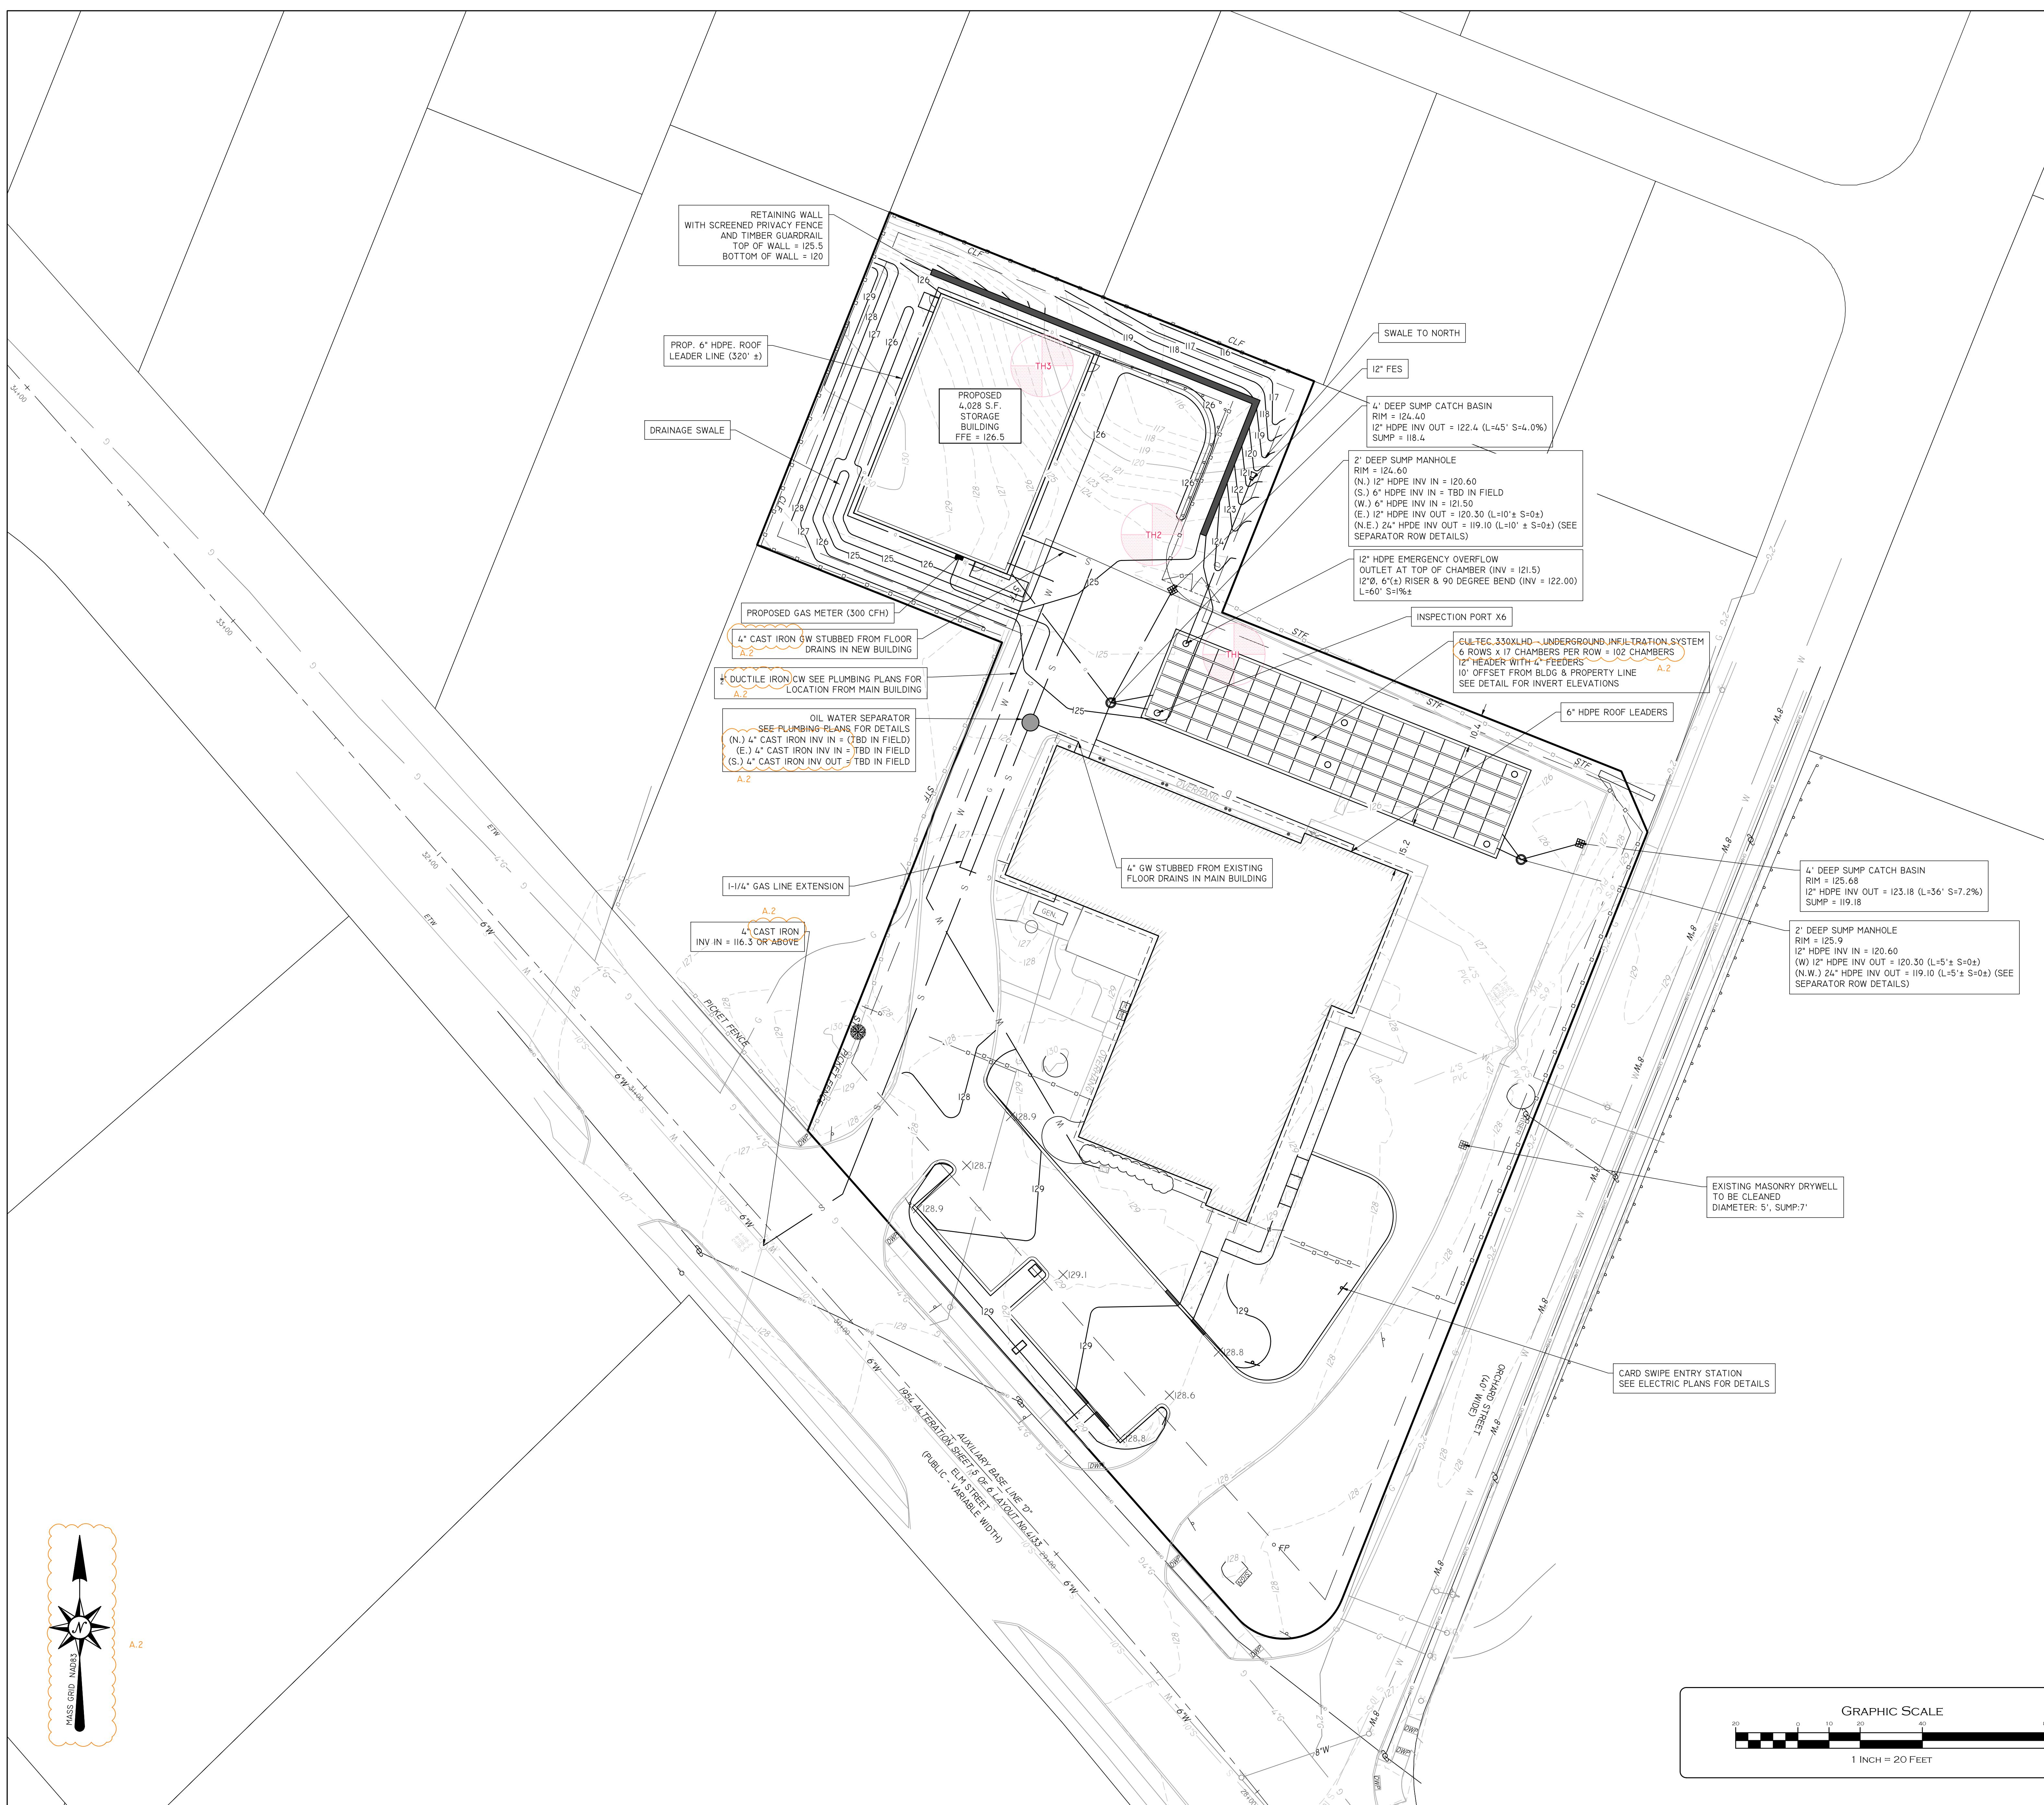


IN SITE Engineering Services, LLC
PROFESSIONAL ENGINEERS LAND SURVEYORS
Precision. Clarity. Certainty.
InSite Professional Complex, Suite 1
1539 Fall River Avenue Seekonk, MA 02771
Phone: (508) 336-4500 Fax: (508) 336-4558
Web Address: InsiteEngineers.com

50 Holden Street
Providence, Rhode Island 02908
Phone: (401) 272-1730
Fax: (401) 273-156
E-mail: rgbinfo@rgb.net
www.rgben.org
Architecture - Project Management - Interior Design

Project
**DEDHAM-
WESTWOOD
WATER DISTRICT**

**STORAGE
FACILITY**

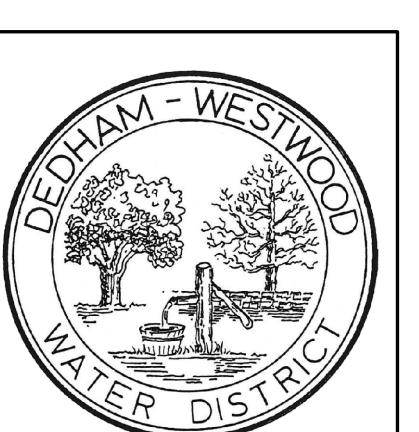

50 ELM STREET
DEDHAM, MA 02026

Drawing Status
**100% CONSTRUCTION
DOCUMENTS**

Issued On 6/28/2024


Sheet Contents
**GRADING,
DRAINAGE, AND
UTILITY PLAN**

Project Number. 6790
Drawing No. C004

Sheet 4 of 8




Drawn by L.J.G.
Checked by P.D.C.
Revised on ADDENDUM #2 - 6.28.2024

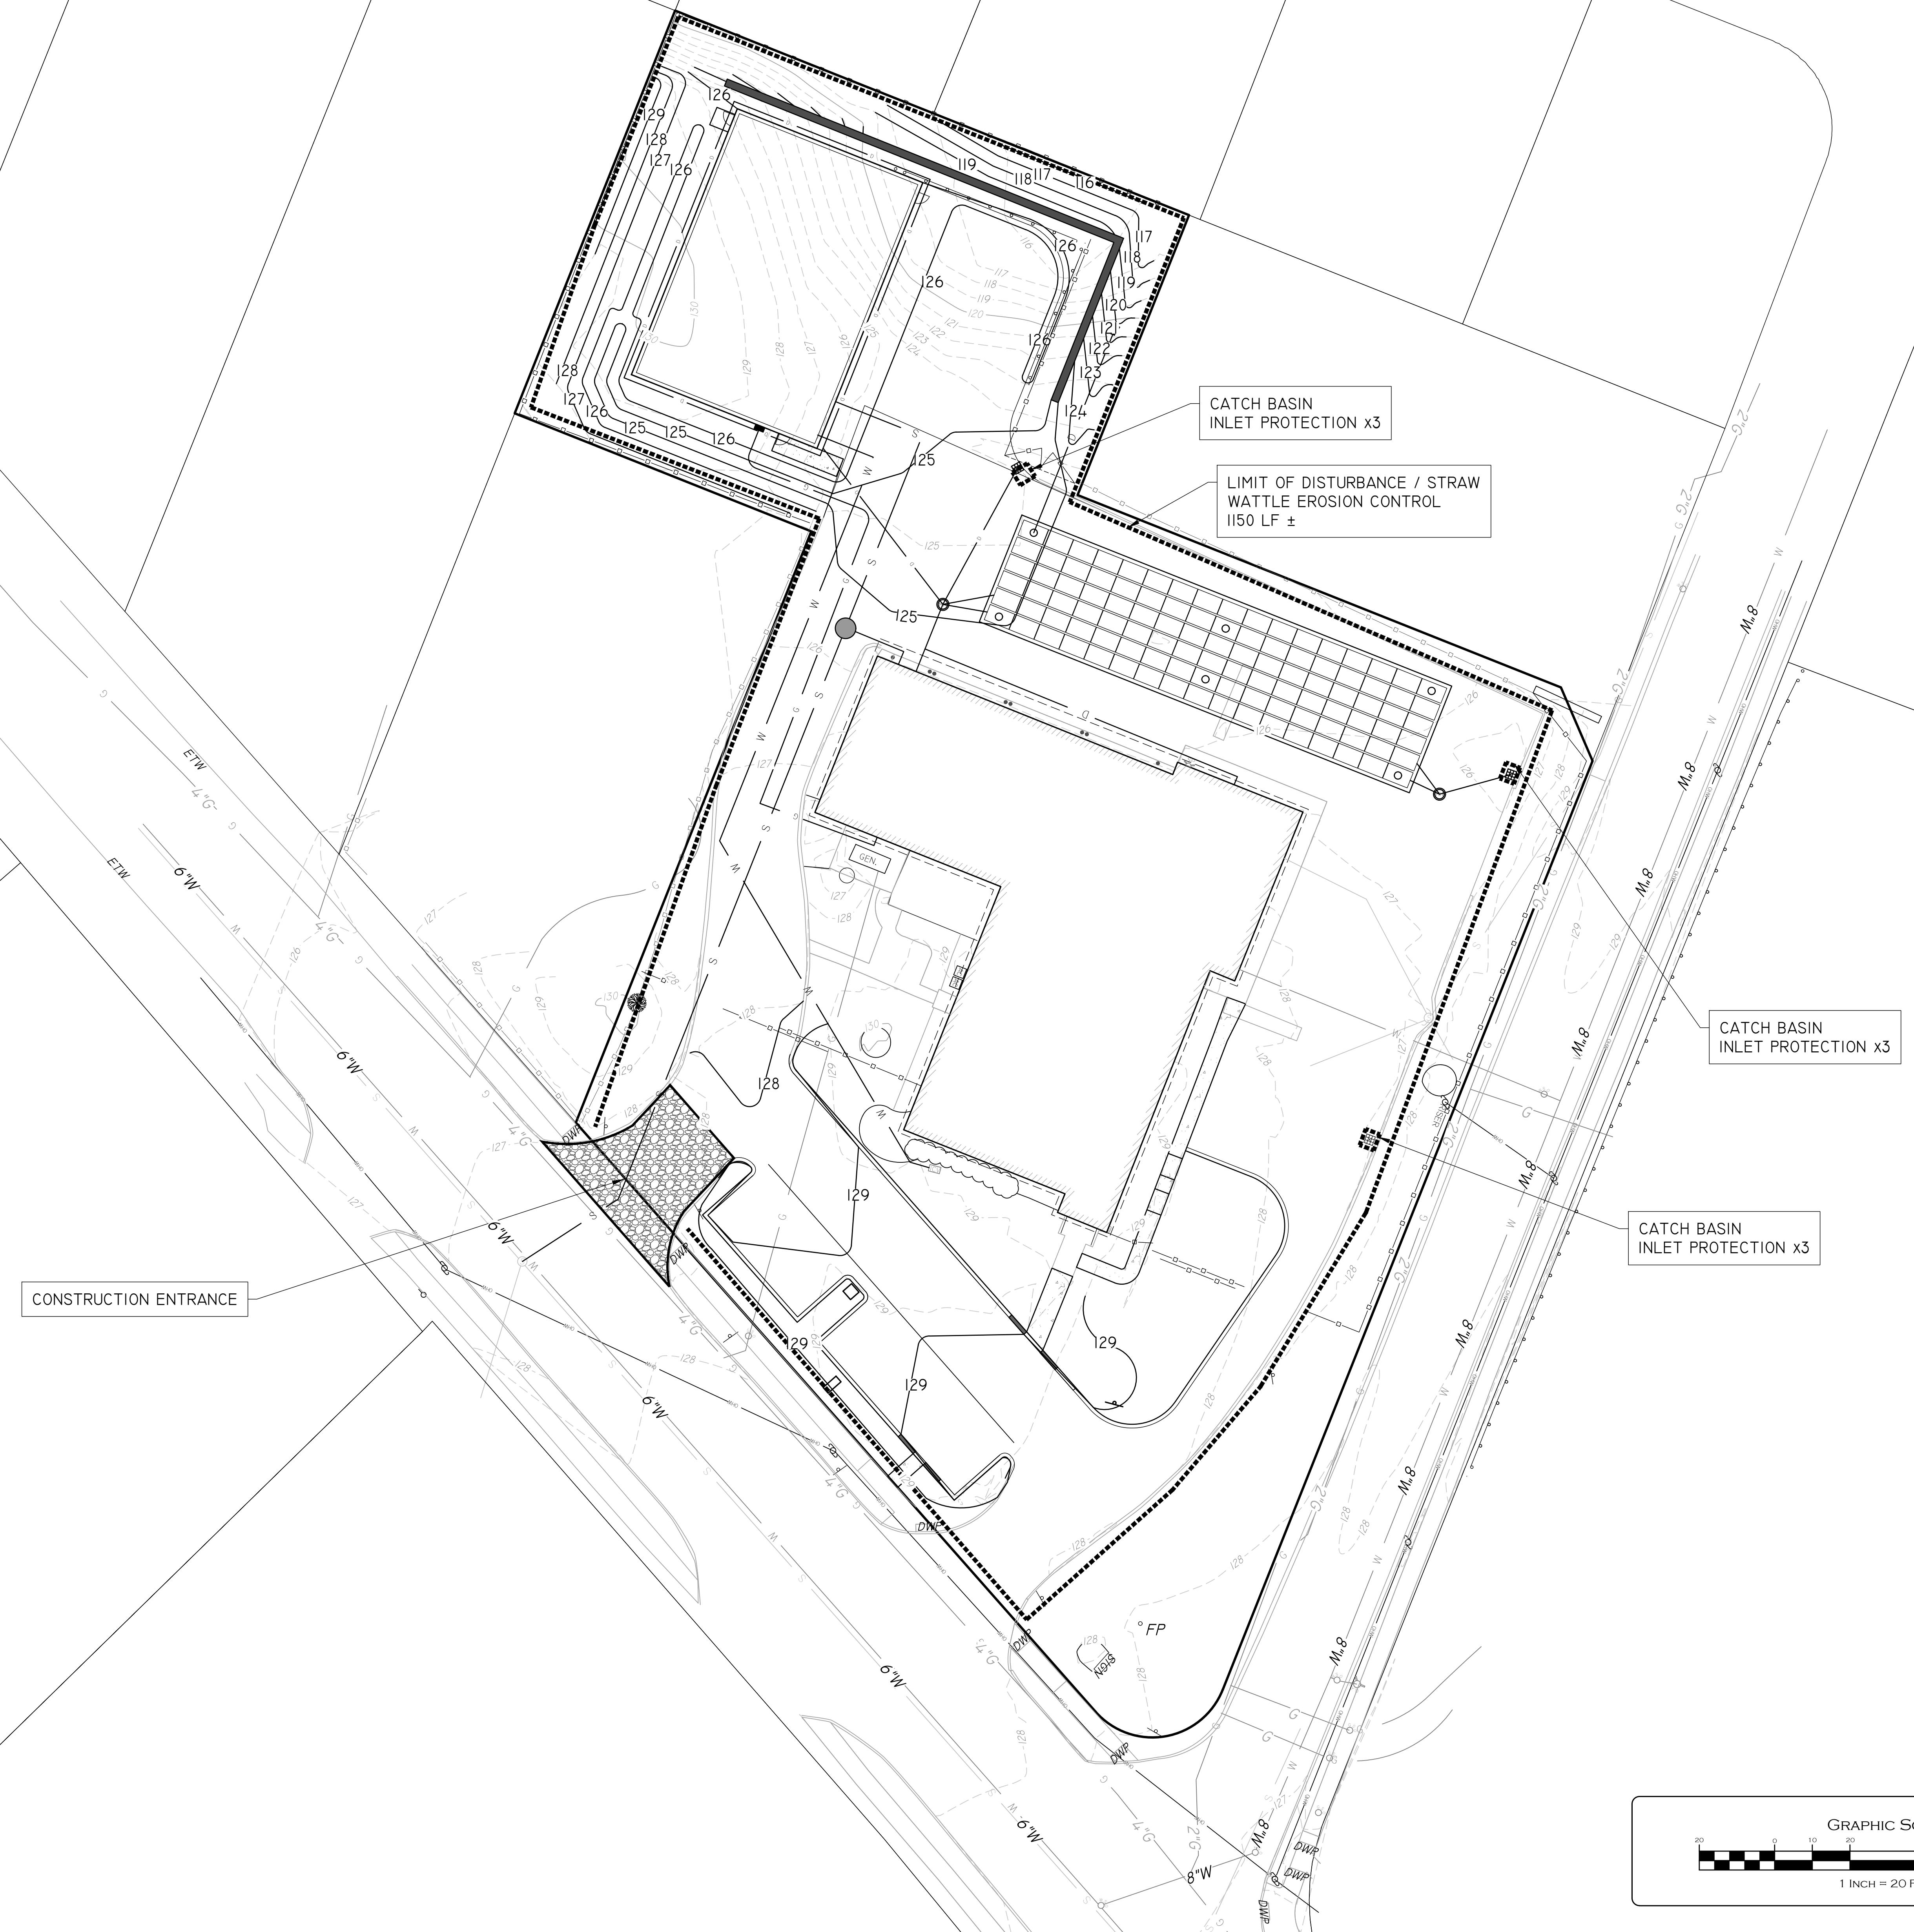

InSite Engineering Services, LLC
PROFESSIONAL ENGINEERS / LAND SURVEYORS
Precision. Clarity. Certainty.
InSite Professional Complex, Suite 1
1539 Fall River Avenue Seekonk, MA 02771
Phone: (508) 336-4500 Fax: (508) 336-4558
Web Address: InsiteEngineers.com

50 Holden Street
Providence, Rhode Island 02908
Phone: (401) 272-1730
Fax: (401) 273-156
E-mail: rgbinfo@gb.net
www.gb.net
Architecture • Project Management • Interior Design
Project

**DEDHAM-
WESTWOOD
WATER DISTRICT**
STORAGE
FACILITY

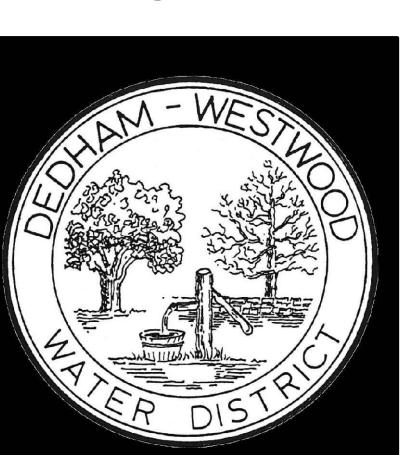

50 ELM STREET
DEDHAM, MA 02026

Drawing Status
100% CONSTRUCTION
DOCUMENTS

Issued On 6/28/2024

Sheet Contents
**EROSION &
SEDIMENT
CONTROL PLAN**

Project Number. 6790
Drawing No. C005
Sheet 5 of 8




Drawn by L.J.G.

Checked by P.D.C.

Revised on


ADDENDUM #2 - 6.28.2024

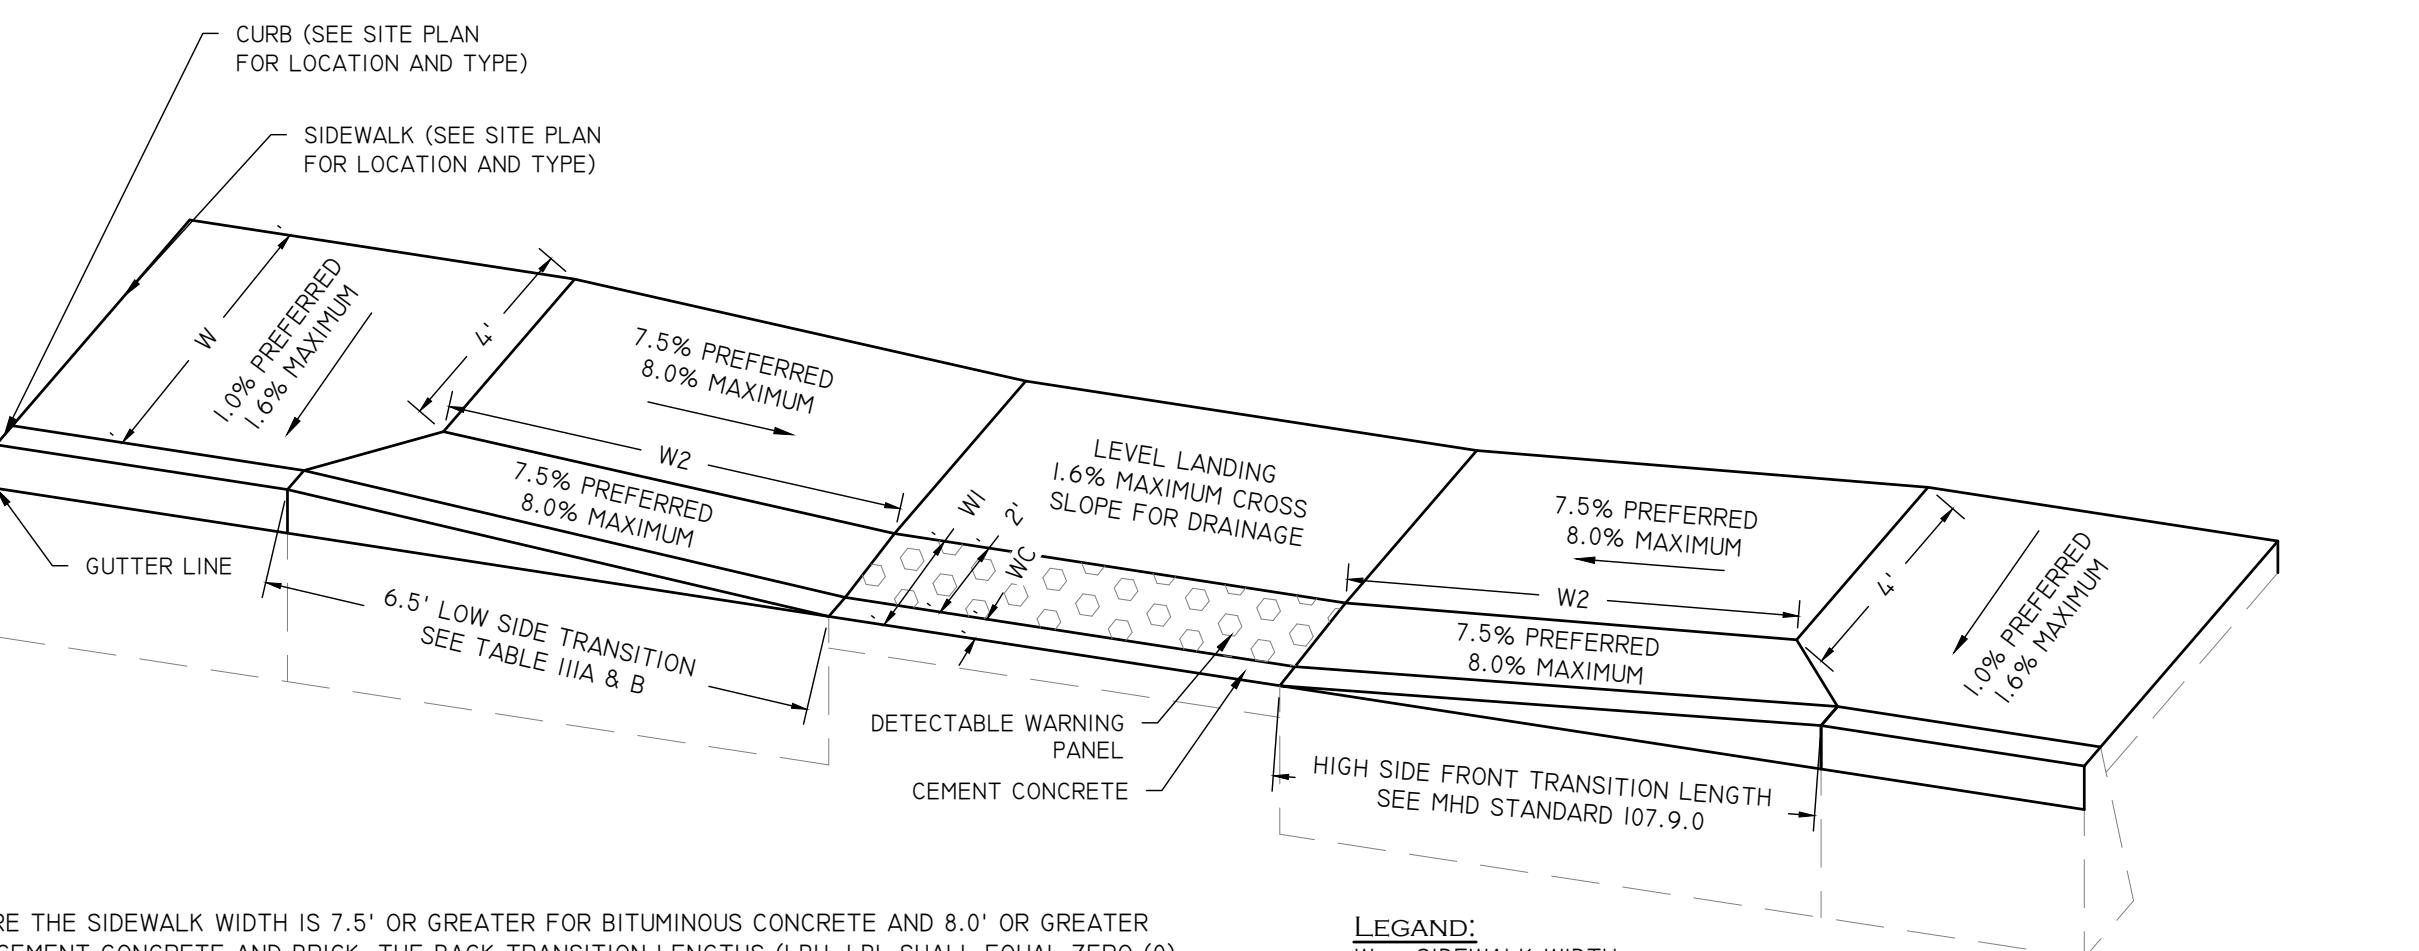

NOTES:
1. WHERE THE SIDEWALK WIDTH IS 7.5' OR GREATER FOR BITUMINOUS CONCRETE AND 8.0' OR GREATER FOR CEMENT CONCRETE AND BRICK, THE BACK TRANSITION LENGTHS (L1H, L1B) SHALL EQUAL ZERO (0). THEREFORE THE DIAGONAL SCRE LINE SHALL MEET THE BACK CORNERS OF THE WHEELCHAIR RAMP. IT SHOULD BE NOTED THAT THE RAMP SLOPE SHALL BE LESS THAN 11.0' FOR BITUMINOUS CONCRETE AND GREATER THAN 8.0' TO LESS THAN 11.0' FOR CEMENT CONCRETE AND BRICK.
2. TRANSITION CURB SHALL BE PART OF THE HANDICAP RAMP WORK.

WHEELCHAIR RAMP DETAIL


NOT TO SCALE

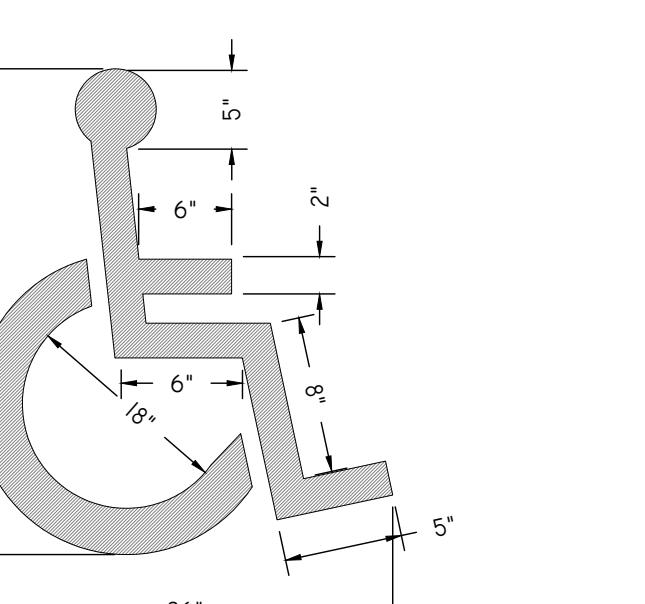

NOTES:
1. ALL HANDICAP PARKING AND SIGNALS SHALL BE IN CONFORMANCE WITH THE RULES AND REGULATIONS OF THE ARCHITECTURAL BARRIERS BOARD

HANDICAP PAVEMENT MARKING

NOT TO SCALE

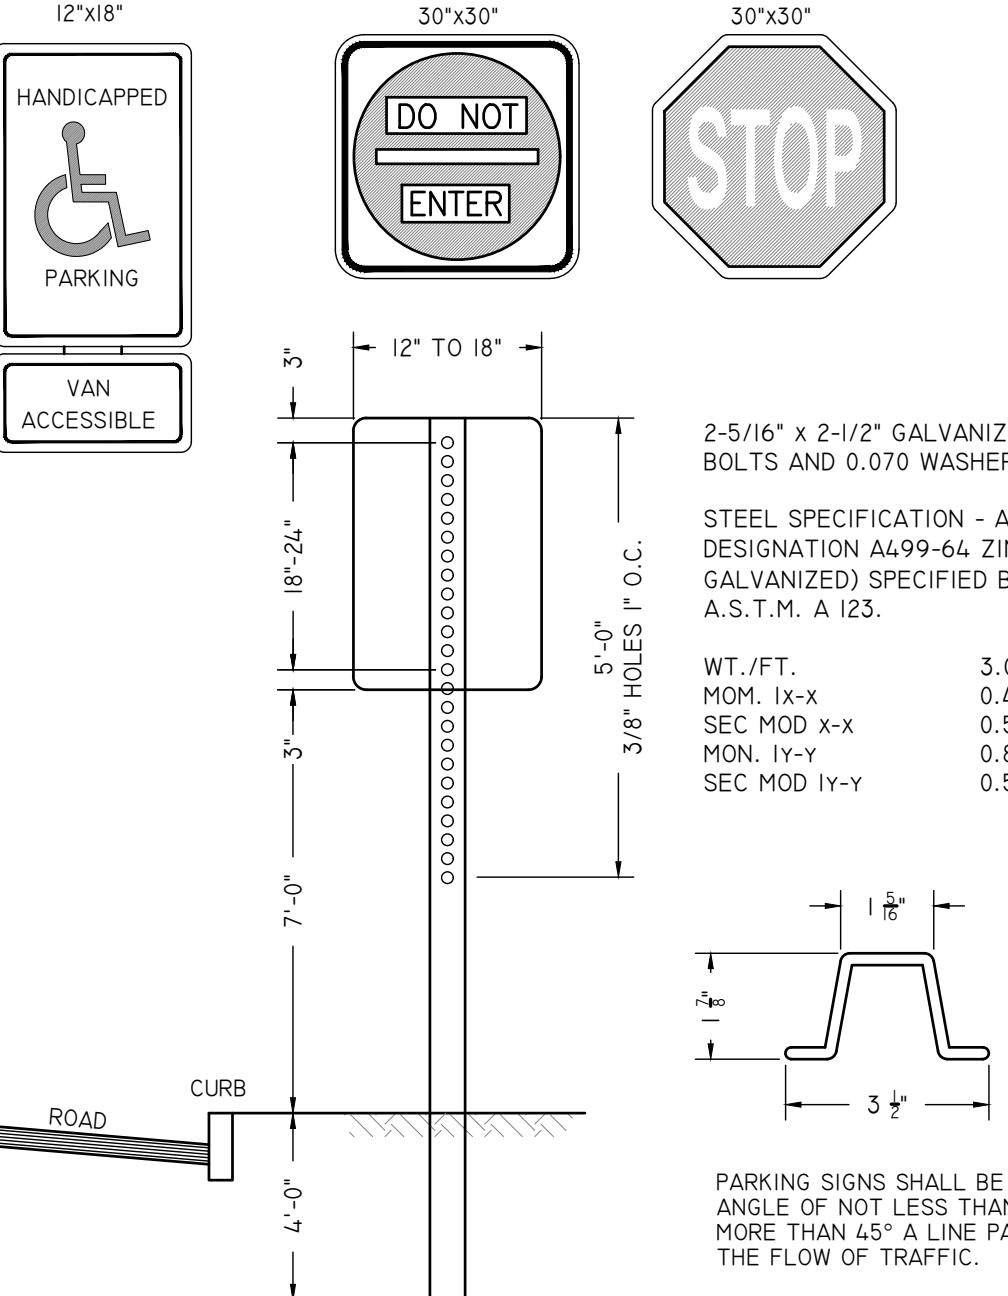


PARKING SIGNS SHALL BE SET AT AN ANGLE OF NOT LESS THAN 30° NOR MORE THAN 45° A LINE PARALLEL TO THE FLOW OF TRAFFIC.

SIGN MOUNTING NOTES:
1. ALL LAG SCREWS AND WASHERS SHALL BE GALVANIZED 5/16" x 2 1/2" LONG UNLESS OTHERWISE NOTED.
2. ALL SIGNS SHALL BE 1/2" THICK.
3. ALL SIGN COLORS, RADII AND BORDERS AS SPECIFIED IN MANUAL ON "UNIFORM TRAFFIC CONTROL DEVICES" OR AS SPECIFIED BY MHD

HANDICAP SIGN NOTES:
1. ALL HANDICAP PARKING AND SIGNALS SHALL BE IN CONFORMANCE WITH THE RULES & REGULATIONS OF THE ARCHITECTURAL BARRIERS BOARD.
2. SIGNS SHALL BE LOCATED SO THEY CANNOT BE OBSCURED BY A VEHICLE PARKED IN THE SPACE.
3. FOR HANDICAPPED VAN SPACE USE SIGN AS DETAILED.
4. FOR HANDICAPPED SPACE FOR AUTOMOBILES USE ONLY HANDICAPPED PARKING SIGN.

SIGN MOUNTING


NOT TO SCALE

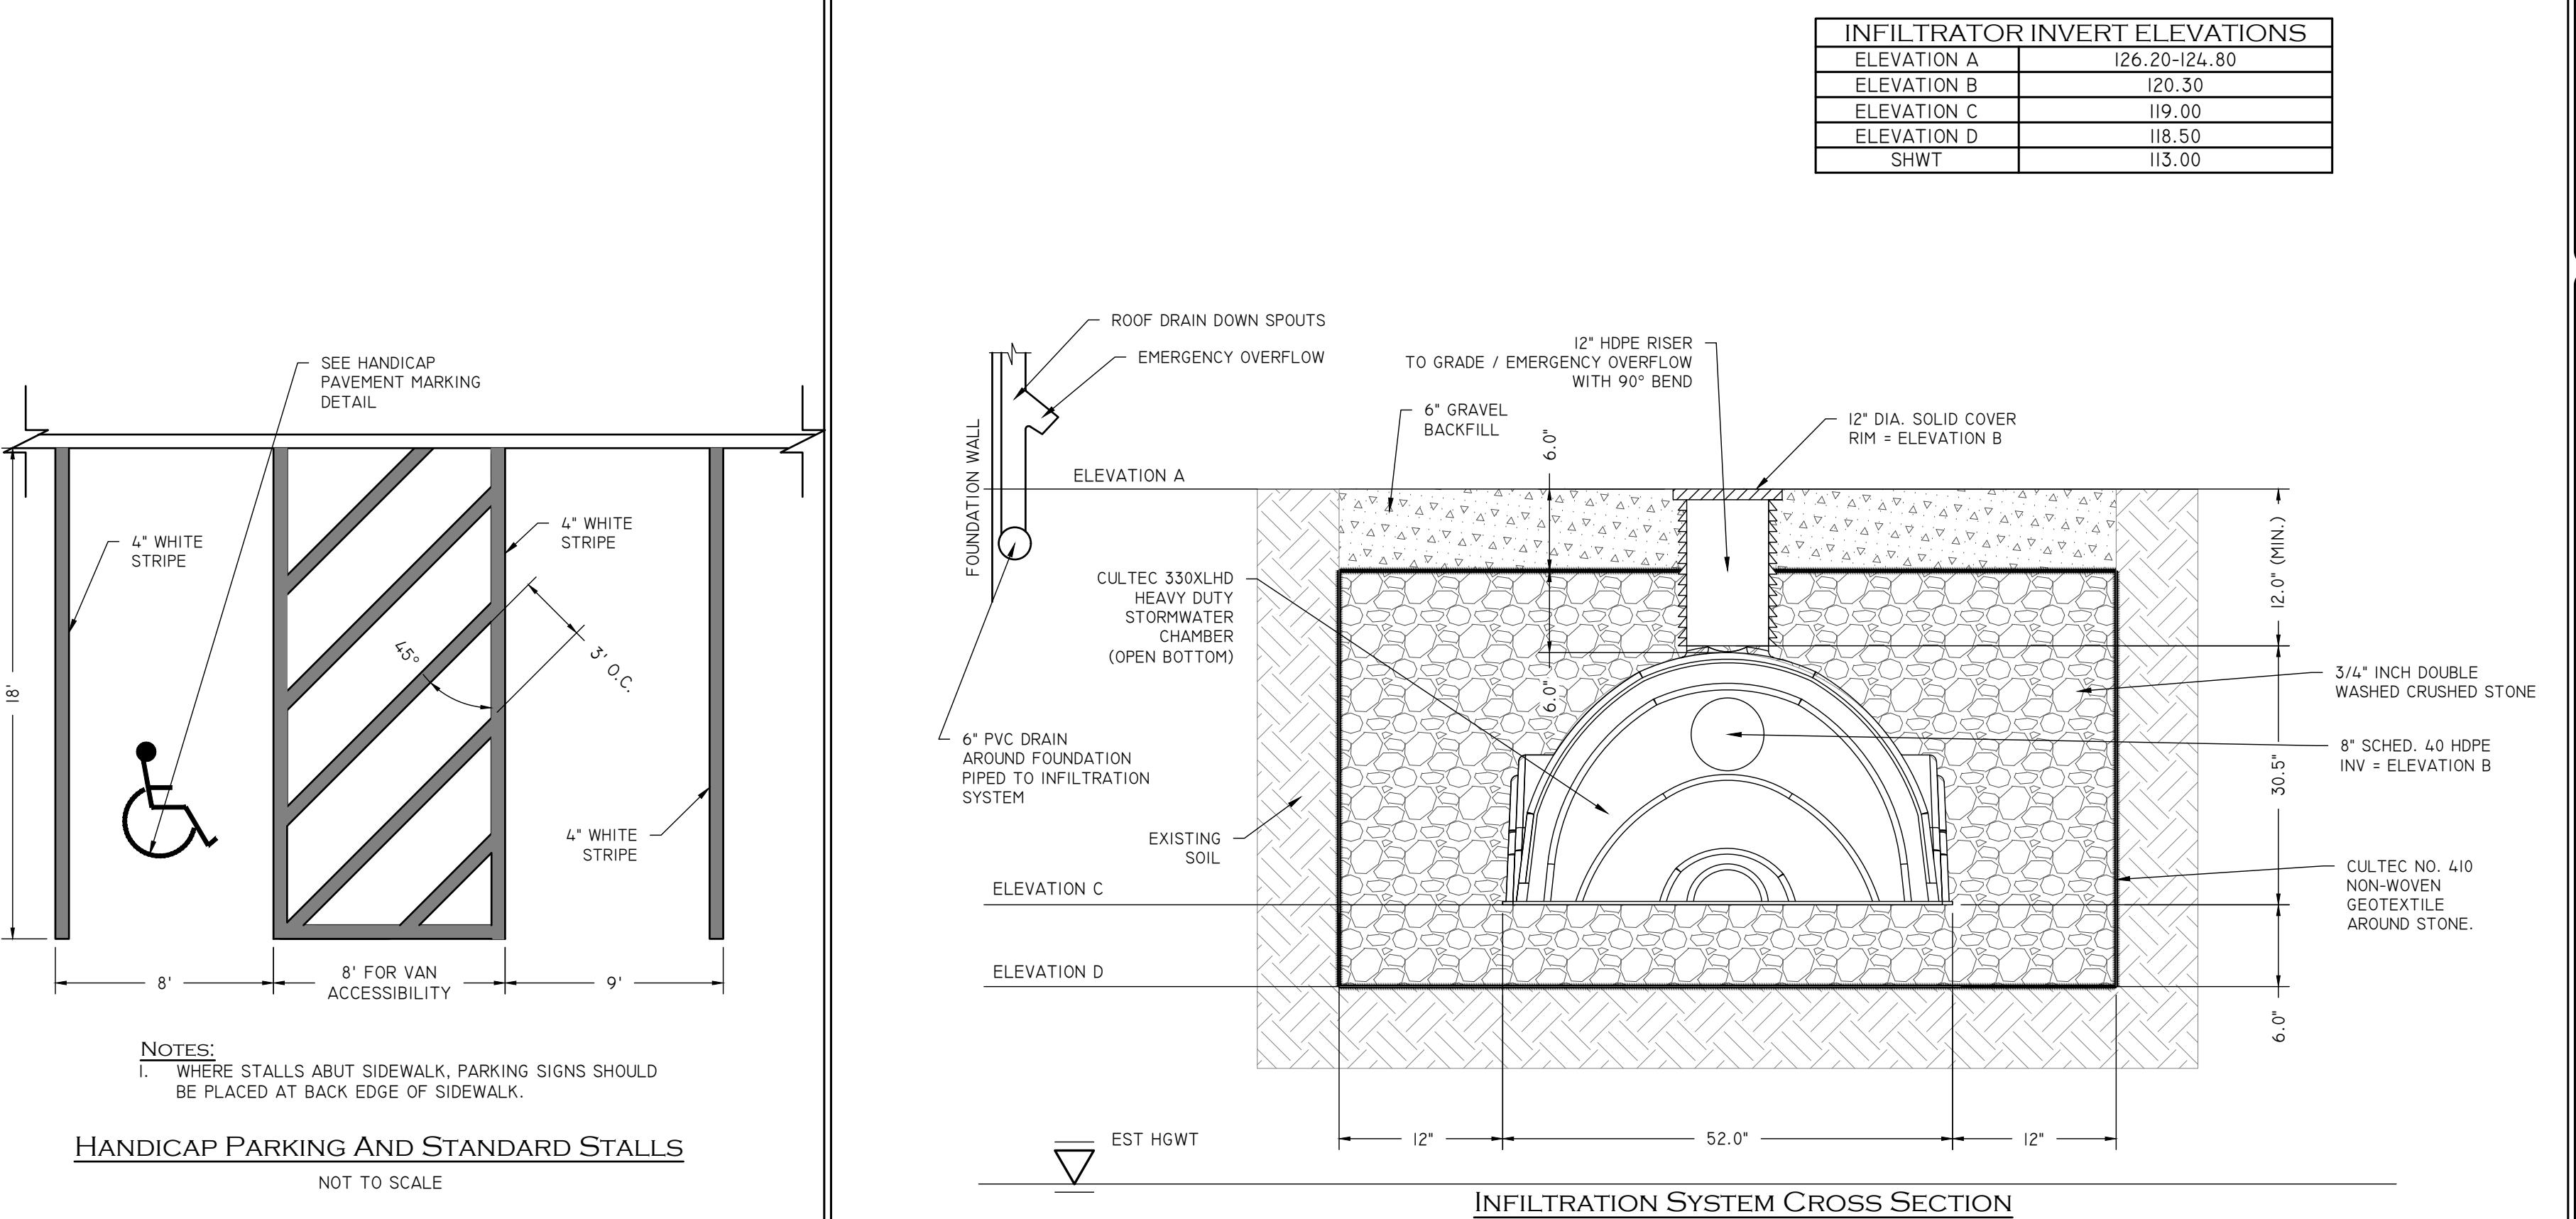

NOTES:
1. WHERE STALLS ABUT SIDEWALK, PARKING SIGNS SHOULD BE PLACED AT BACK EDGE OF SIDEWALK.

HANDICAP PARKING AND STANDARD STALLS


NOT TO SCALE

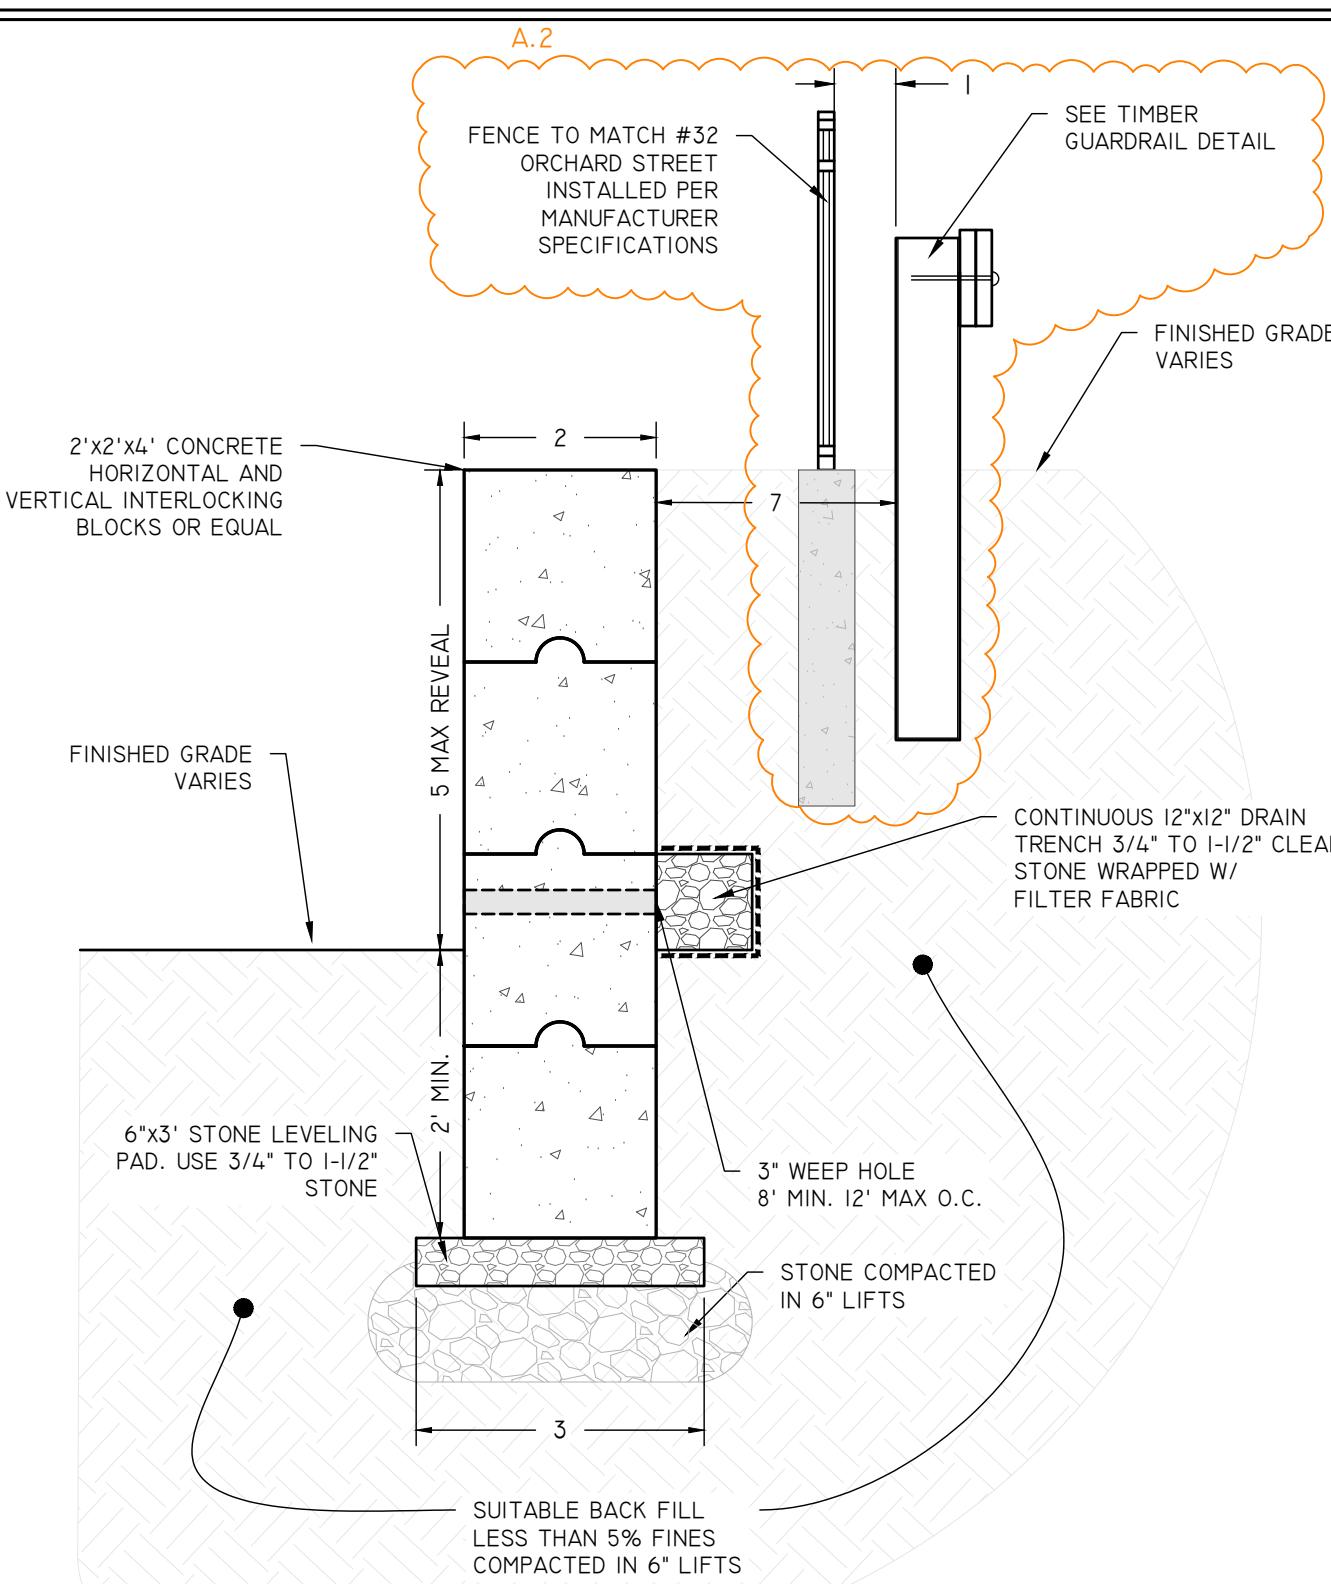

NOTES:
1. EDITION BLOCK TO BE 2x6" MIN. BELOW GRADE PLACED ON A 6" THICK x3" WIDE STONE LEVELING PAD, CONSTRUCTED WITH 3/4" TO 1 1/2" STONE.
2. REMOVE UNSUITABLE SOIL BELOW WALL AND REPLACE WITH STONE COMPAKED IN 6" LIFTS.
3. 1" MIN. REVEAL FOR STONE LEVELing PAD.
4. REFERENCE METHOD OF SETTING VERTICAL CURB, TIMBER GUARDRIAL, AND 4' ORNAMENTAL FENCE, AND LANDSCAPE DETAILS AND NOTES WHILE INSTALLING RELEVANT COMPONENTS.

INTERLOCKING BLOCK WALL DETAIL


SCALE: 1/2" = 1'

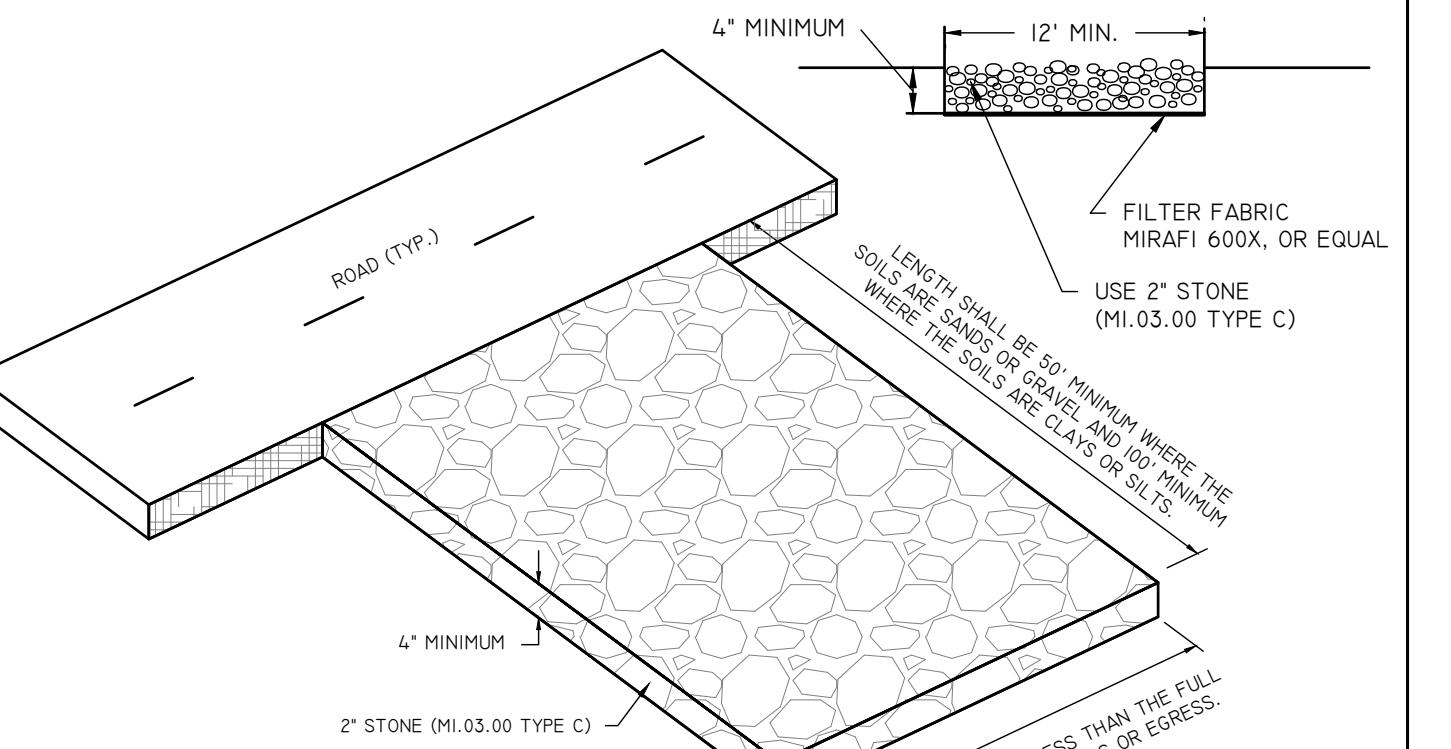

INSTALLATION:
THE AREA WHERE ENTRANCE SHOULD BE CLEARED OF ALL VEGETATION, ROOTS, AND OTHER OBJECTIONABLE MATERIAL. THE STONE SHALL BE PLACED TO THE SPECIFIED DIMENSIONS, AS NOTED ABOVE.
Maintenance:
MAINTENANCE: THE ENTRANCE SHALL BE MAINTAINED IN A CONDITION WHICH WILL PREVENT TRACKING OR FLOWING OF SEDIMENTS INTO PUBLIC RIGHT-OF-WAYS THIS WILL REQUIRE PERIODIC TOP DRESSING WITH ADDITIONAL STONE, OR ADDITIONAL STONE AS CONDITIONS DEMAND, AND REPAIR, AND / OR CLEANOUT OF ANY MEASURES TO TRAP SEDIMENT. ALL SEDIMENT SPILLED, DROPPED, WASHED OR TRACKED ONTO PUBLIC RIGHT-OF-WAYS MUST BE REMOVED IMMEDIATELY.
LOCATION:
SEE OVERALL SHEET FOR LOCATION OF CONSTRUCTION ENTRANCE.

CONSTRUCTION ENTRANCE DETAIL

NOT TO SCALE

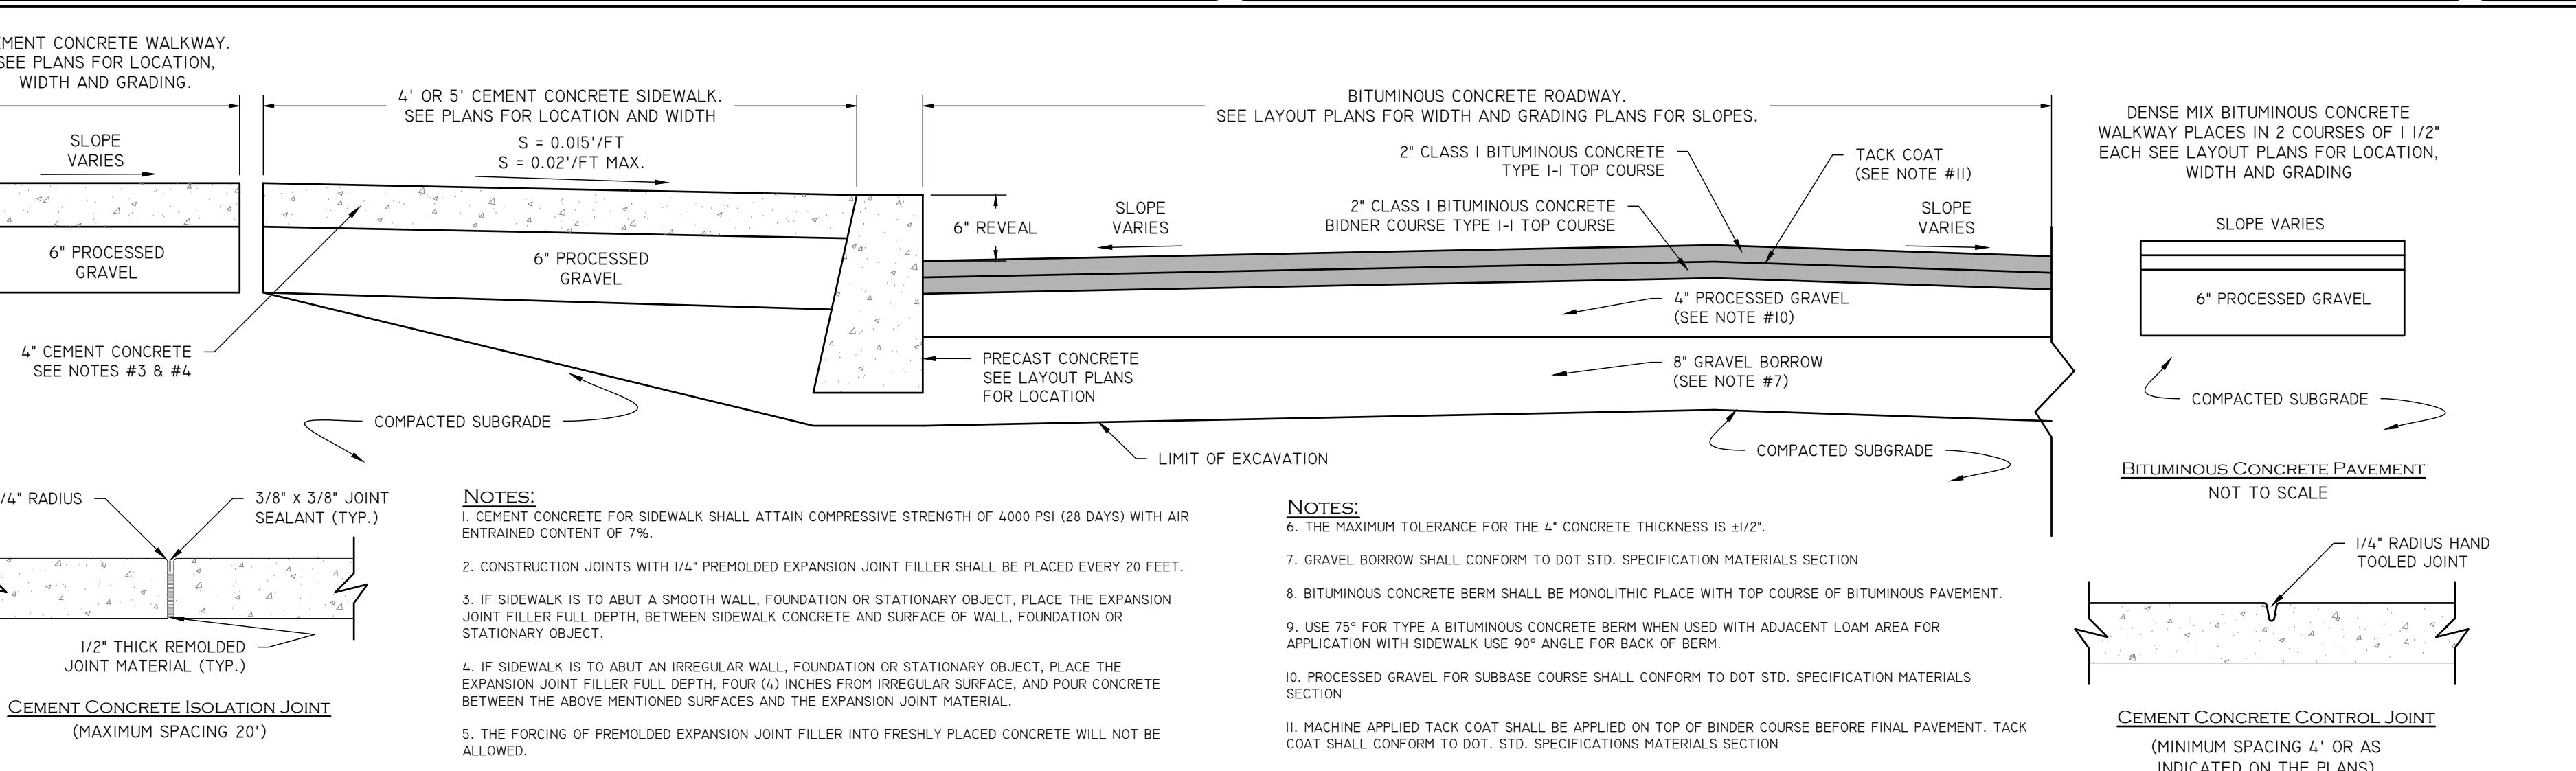

PAVEMENT, SIDEWALK AND WALKWAY DETAIL

NOT TO SCALE




50 Holden Street
Providence, Rhode Island 02908
Phone: (401) 272-7730
Fax: (401) 273-156
E-mail: rginfo@rg.net
www.gh.net

Architecture - Project Management - Interior Design
Project

DEDHAM- WESTWOOD WATER DISTRICT

STORAGE FACILITY

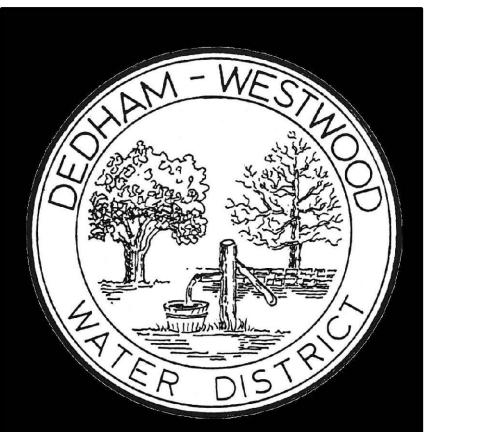

50 ELM STREET
DEDHAM, MA 02026
Drawing Status
100% CONSTRUCTION DOCUMENTS

Issued On 6/28/2024

Sheet Contents
**DETAIL SHEET
(1 OF 3)**


Project Number. 6790

Drawing No. C006

Sheet 6 of 8




Drawn by L.J.G.
Checked by P.D.C.
Revised on ADDENDUM #2 - 6.28.2024

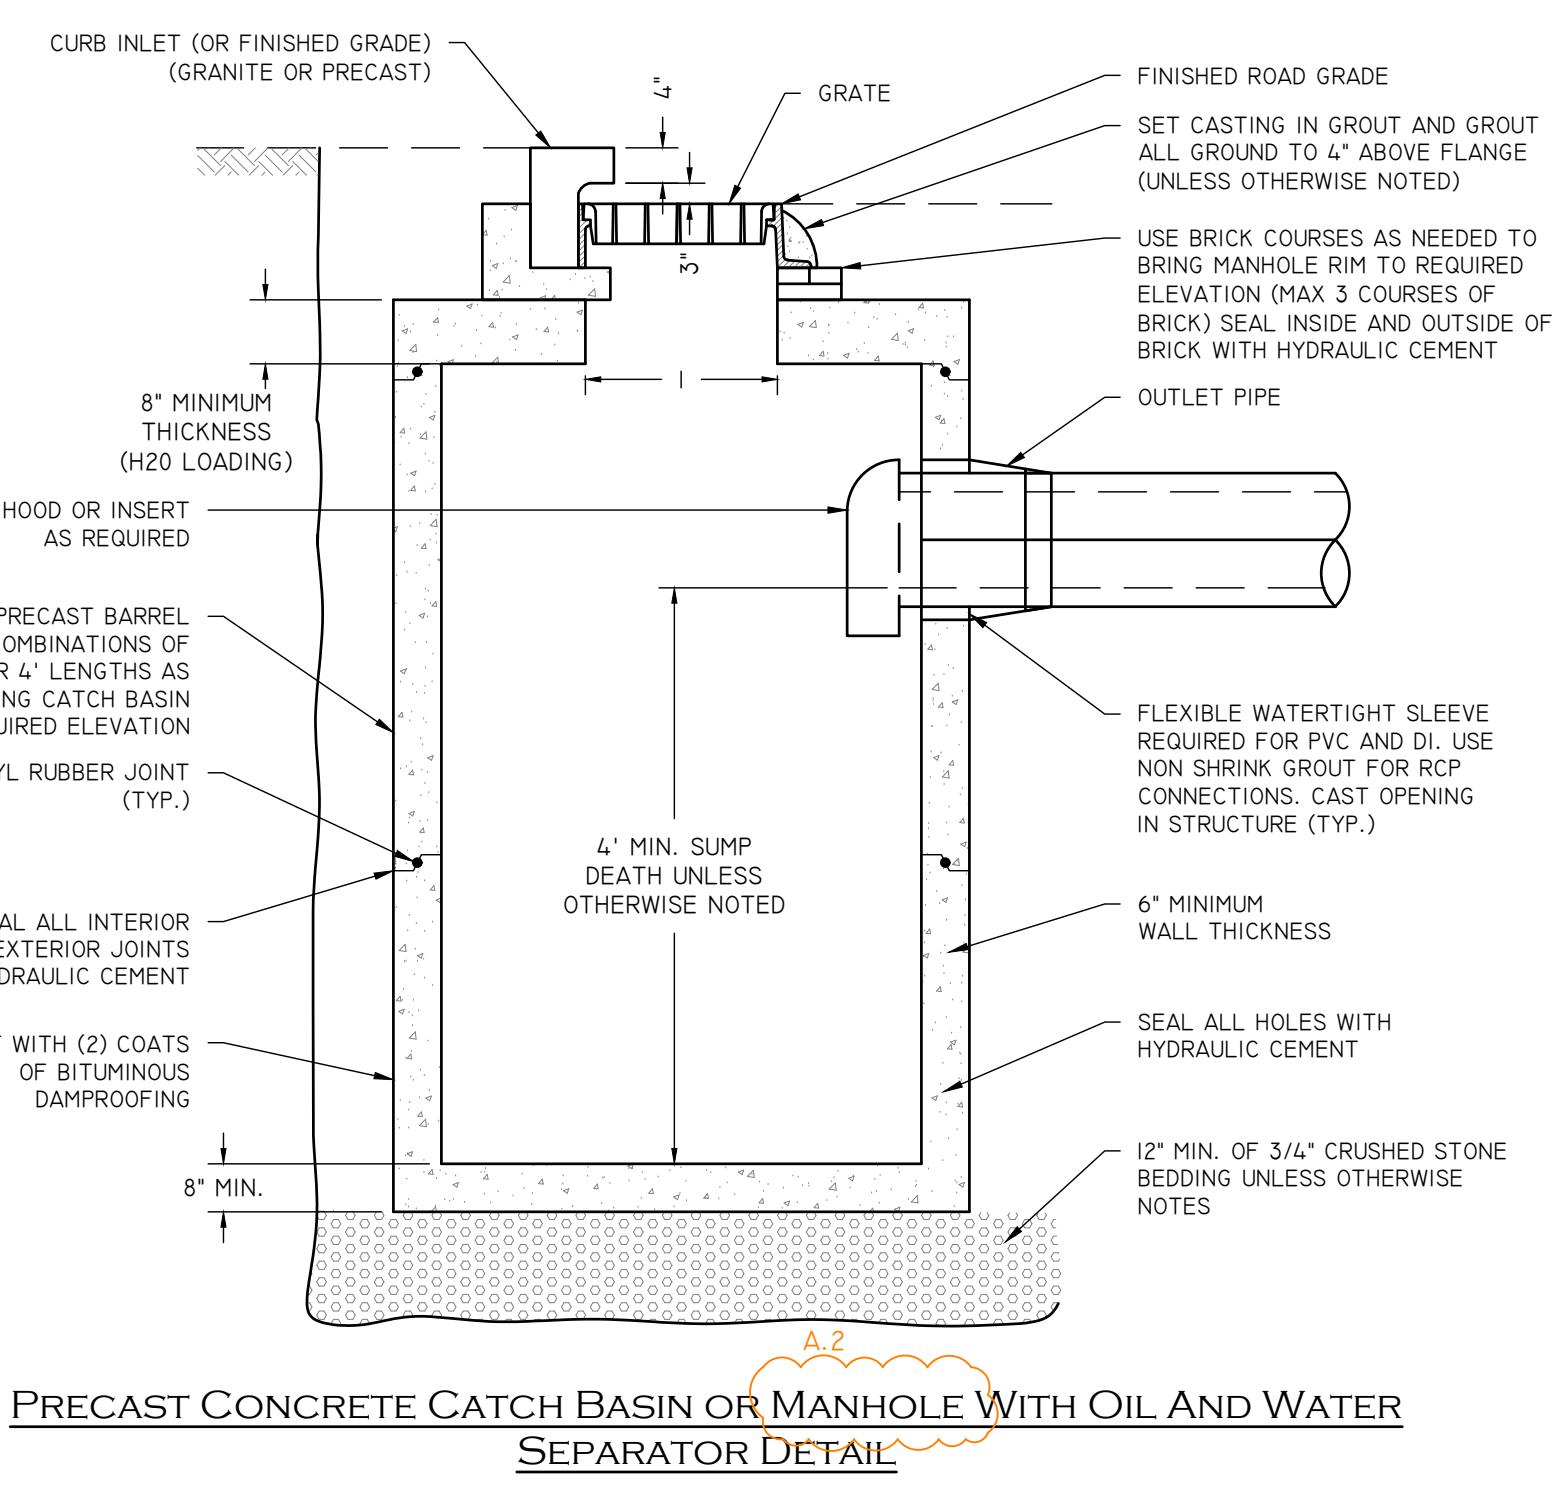

PRECAST CONCRETE CATCH BASIN OR MANHOLE WITH OIL AND WATER SEPARATOR DETAIL


NOT TO SCALE

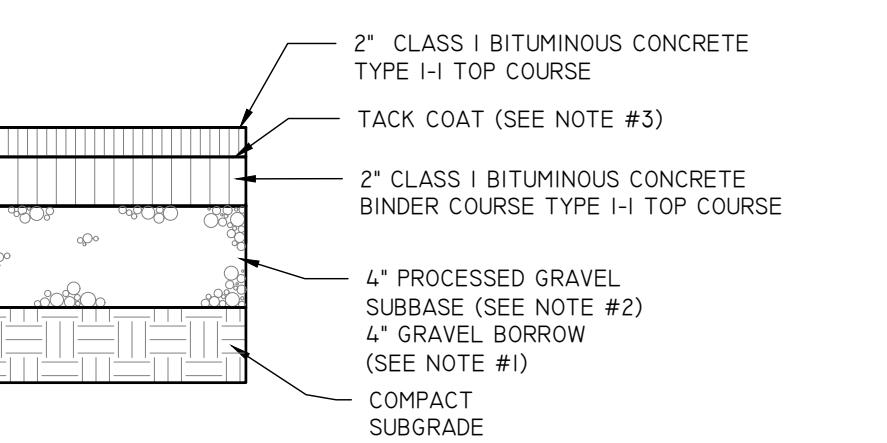

NOTES:
1. GRAVEL BORROW SHALL CONFORM TO DOT STD. SPECIFICATION MATERIALS SECTION
2. PROCESSED GRAVEL FOR SUBBASE COURSE SHALL CONFORM TO DOT STD. SPECIFICATION MATERIALS SECTION
3. MACHINE APPLIED TACK COAT SHALL BE APPLIED ON TOP OF BINDER COURSE BEFORE FINAL PAVEMENT. TACK COAT SHALL CONFORM TO DOT STD. SPECIFICATIONS MATERIALS SECTION

BITUMINOUS CONCRETE PAVEMENT DETAIL

NOT TO SCALE

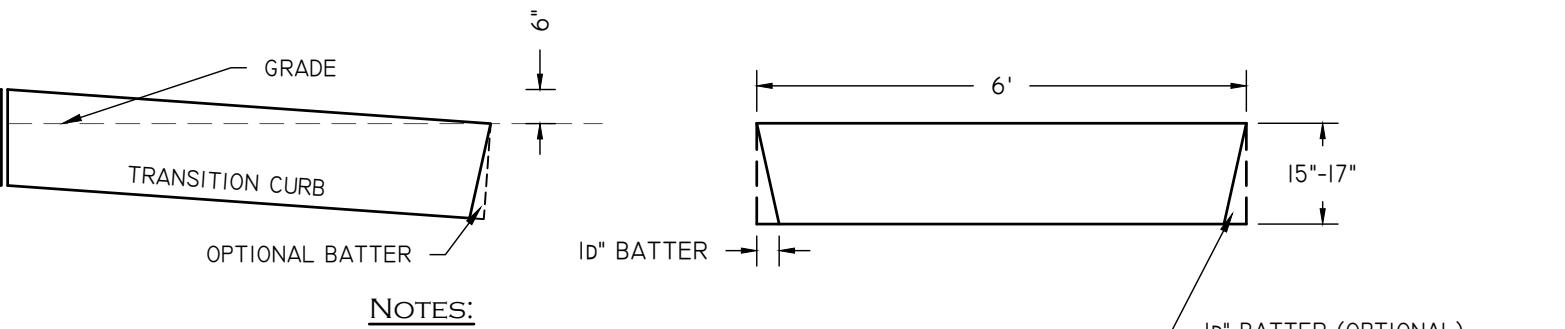


6' PRECAST TRANSITION CURB

NOT TO SCALE


EROSION & SEDIMENTATION CONTROL:

- BEGIN AT THE LOCATION WHERE WATTLE IS TO BE INSTALLED BY EXCAVATING 2-3' DEEP x 9' WIDE TRENCH ALONG THE CONTOUR OF THE SLOPE. EXCAVATED SOIL SHOULD BE PLACED UP SLOPE FROM THE ANCHOR TRENCH.
- PLACE THE WATTLE IN THE TRENCH SO THAT IT CONTOURS TO THE SOIL SURFACE. COMPACT SOIL FROM THE EXCAVATED TRENCH AGAINST THE WATTLE ON THE UP-slope SIDE. ADJACENT WATTERS SHOULD TIGHTLY ABUT.
- SECURE THE WATTLE TO THE SOIL WITH 1/2" STAKES every 3'-0" apart. A STAKE ON EACH END. STAKES SHOULD BE DRIVEN THROUGH THE MIDDLE OF THE WATTLE LEAVING AT LEAST 2'-3" OF STAKE EXTENDING ABOVE THE STAKES SHOULD BE DRIVEN PERPENDICULAR TO SLOPE FACE.
- CONTRACTOR IS RESPONSIBLE TO MAINTAIN INTEGRITY OF STRAW WATTLE FOR DURATION OF CONSTRUCTION.
- EROSION CONTROLS TO REMAIN UNTIL SOIL CONDITIONS STABILIZE.
- LOOSE HAY TO BE SPREAD ON AREAS OF EXPOSED LOAM & SEED UNTIL GERMINATION AND STABILIZATION OCCURS.

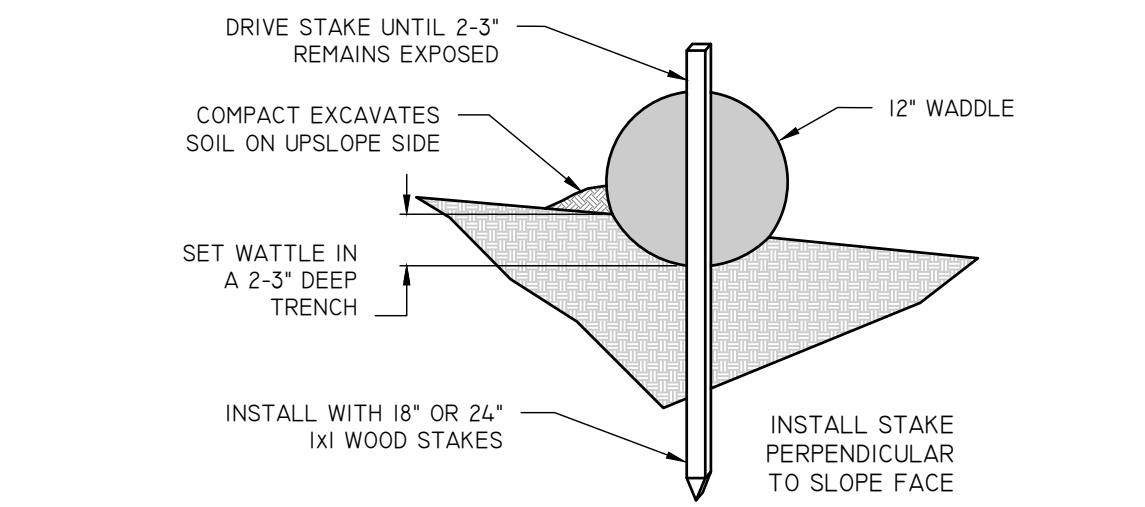


STRAW WATTLE (OR SILT SOCK) DETAIL

NOT TO SCALE

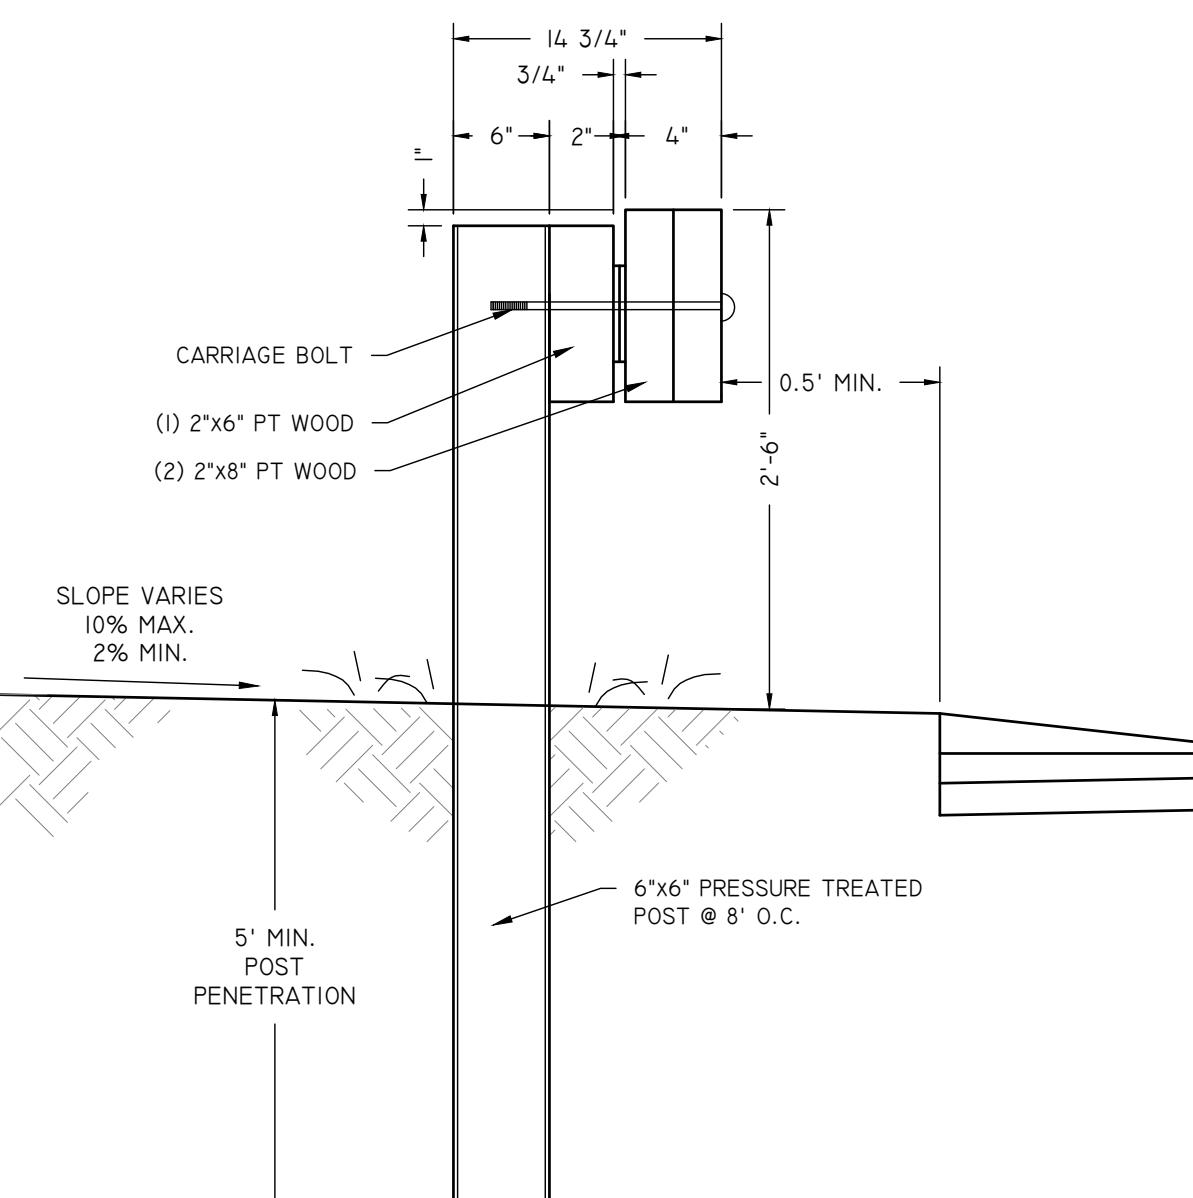

TIMBER GUARDRAIL DETAIL

NOT TO SCALE

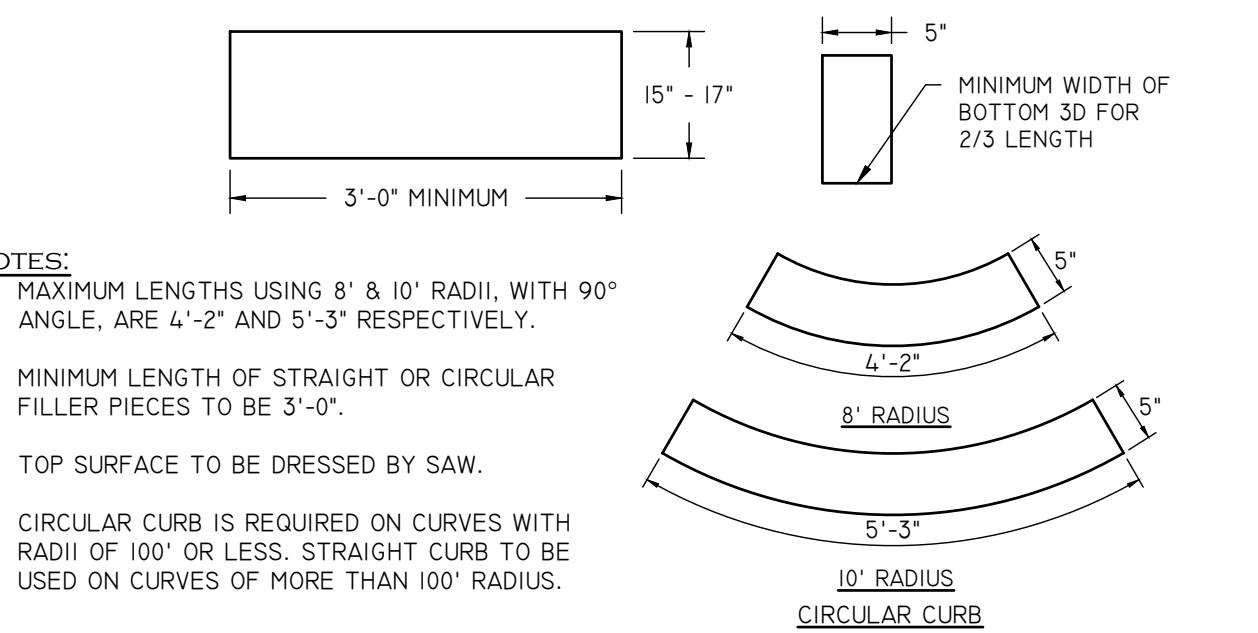


PRECAST CONCRETE CURB

NOT TO SCALE


ALUMINUM FENCE INSTALLATION INSTRUCTIONS

FENCE ASSEMBLY OVERVIEW

- POST AND PANEL HEIGHTS VARY BY FENCE SYSTEM
- BURIED POSTS AND PANEL WIDTHS ARE CONSISTENT BETWEEN SYSTEMS

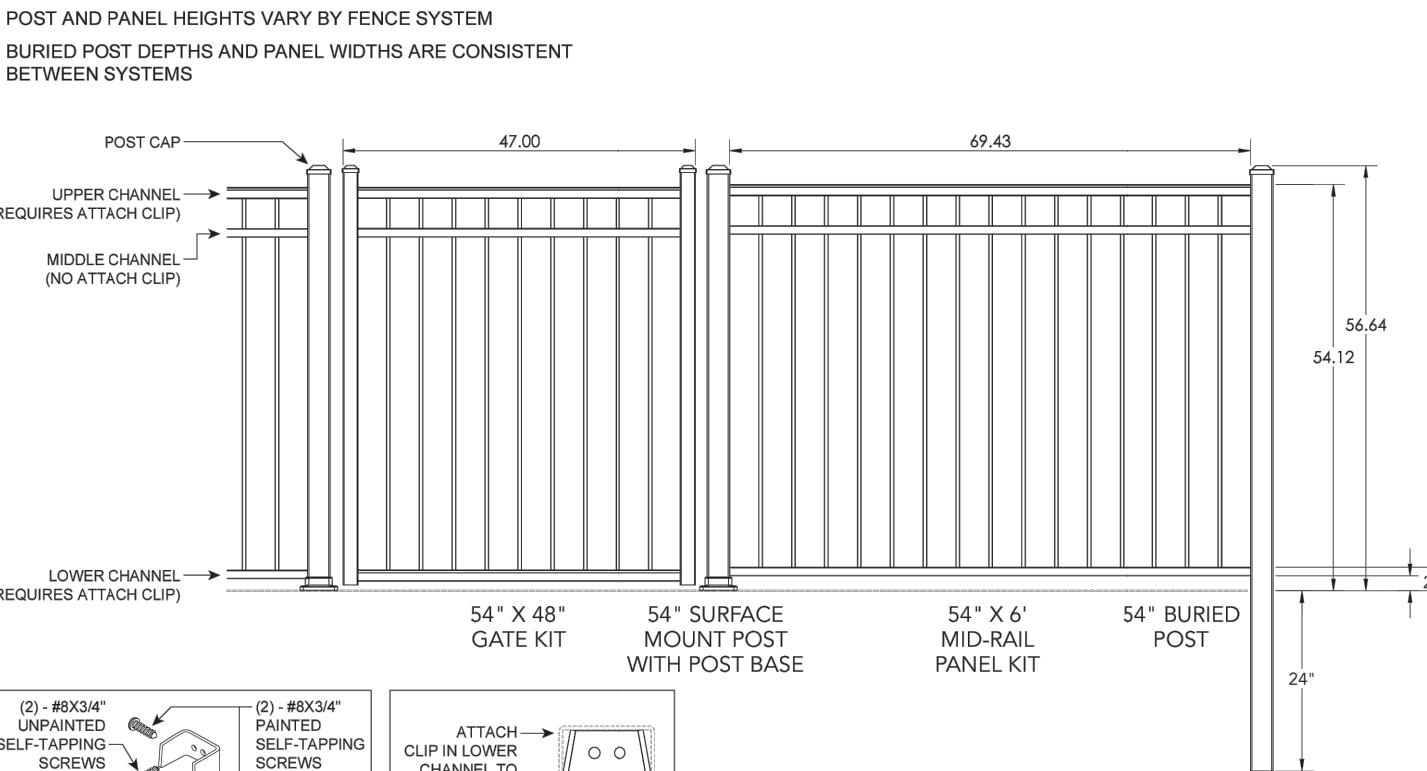

ITEMS REQUIRED FOR INSTALLATION

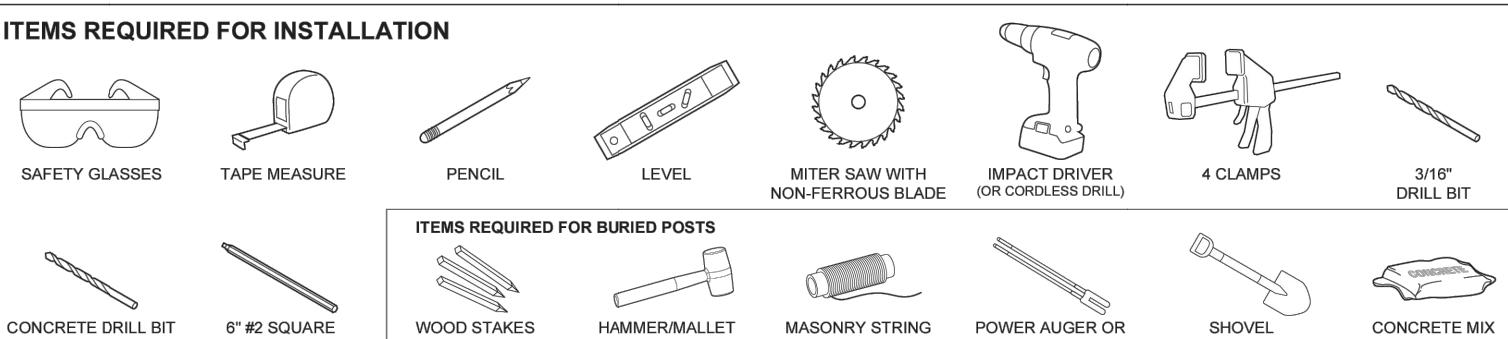

IMPORTANT NOTES:

- Actual fence panel width: 54" = 69 43"
- 5" posts are required to reach 6' lengths.
- Panel attach kits are included with panel kits. If panels are cut down and used as two pieces, additional panel attach kits may be required.
- These instructions cover installation of panels on intermediate sloped ground surfaces up to an 8° angle, but will reduce the distance allowed between posts. CAUTION: Over sloped ground may cause panels to fall.
- 45° fence angles require 22 5/8" clips applied to each side of the post. The 22 5/8" clip kit is sold SEPARATELY.
- These instructions cover the installation of Aluminum Fence. Please visit Manufacturers website for other instructions and products.
- These instructions cover installation of 6' W x 48" H panels. 6' W x 54" Mid-Rail Panels are not covered by these instructions.
- It is the responsibility of the installer to meet all local code requirements and obtain all required building permits. The installer should determine and implement appropriate insulation and weather protection for the fence structure or its needed insulation. It shall not be held responsible for improper or unsafe installation.

- Improper installation of this product can result in personal injury. Always wear safety glasses when cutting, drilling and assembling the product.
- Incorrect products may cause harm to the product or individual.
- DO NOT attempt to assemble products if parts are missing or damaged.

BEFORE YOU BEGIN:
• Check your local zoning laws.
• Local zoning laws and Home Owners Associations may regulate the location, style and height of your fence or even require a permit signoff beforehand.
• Check local codes for frost depth and regulations.
• Check local codes for backfilling requirements.
• You must have the utility companies clearly mark your property for electrical, gas or water lines to avoid puncturing any unseen underground utilities.
• Improper installation of this product can result in personal injury. Always wear safety glasses when cutting, drilling and assembling the product.

CAUTION: Over sloped ground may cause panels to fall.

It is the responsibility of the installer to meet all local code requirements and obtain all required building permits. The installer should determine and implement appropriate insulation and weather protection for the fence structure or its needed insulation. It shall not be held responsible for improper or unsafe installation.

ALUMINUM FENCE INSTALLATION INSTRUCTIONS

A LAY OUT THE PERIMETER

FOR BURIED POSTS:

- Establish your fence line by staking out the area you wish to enclose. Place a stake at all corners, then stretch a masonry string between them to provide straight guide lines. (Dia. 1) TIP: Set the string at exactly 3' high above the ground surface. This will help later to set posts and align them to the height.
- Locate each point in which you will need an end, corner or gate post and mark it with a stake. (Dia. 1) The maximum gap between end posts and a wall or other structure should be less than 4".
- Mark the location of all inline posts and stakes. For 6' sections using 3' posts, measure 72" from center to center (Dia. 2). Actual fence panel width: 6' Panels = 69 43". 3' posts are required to reach 6' lengths. TIP: Fence panels will allow for a MAXIMUM of 72 43" on center. It is easier to cut a panel to 72" than to cut a 6' panel to 69 43" and then add a 1/2" gap.
- Mark the location of gate(s) by placing a stake at each post. Fence gates are 47" wide and require a space of 48" between posts, so 3' posts should measure 51" from center to center. Fence gates cannot be racked and hinges must align, so the posts on each side of gates must be plum and level with each other. (Dia. 3)
- The maximum gap between end posts and a wall or other structure should be less than a 4".

FOR SURFACE MOUNT POSTS:

- Establish your fence line by marking each point in which you will need an end, corner or gate post. The maximum gap between end posts and a wall or other structure should be less than 4".
- Mark the location of all inline posts and stakes. For 6' sections using 3' posts, measure 72" from center to center (Dia. 2). Actual fence panel width: 6' Panels = 69 43". 3' posts are required to reach 6' lengths. TIP: Fence panels will allow for a MAXIMUM of 72 43" on center. It is easier to cut a panel to 72" than to cut a 6' panel to 69 43" and then add a 1/2" gap.
- Mark the location of gate(s) by placing a stake at each post. Fence gates are 47" wide and require a space of 48" between posts, so 3' posts should measure 51" from center to center. Fence gates cannot be racked and hinges must align, so the posts on each side of gates must be plum and level with each other. (Dia. 3)

ITEMS REQUIRED FOR BURIED POSTS

- Local zoning laws and Home Owners Associations may regulate the location, style and height of your fence or even require a permit signoff beforehand.
- Check local codes for frost depth and regulations.
- Check local codes for backfilling requirements.
- You must have the utility companies clearly mark your property for electrical, gas or water lines to avoid puncturing any unseen underground utilities.
- Improper installation of this product can result in personal injury. Always wear safety glasses when cutting, drilling and assembling the product.
- It is the responsibility of the installer to meet all local code requirements and obtain all required building permits. The installer should determine and implement appropriate insulation and weather protection for the fence structure or its needed insulation. It shall not be held responsible for improper or unsafe installation.

ALUMINUM FENCE INSTALLATION INSTRUCTIONS

B INSTALL POSTS

FOR BURIED POSTS:

- Dig a post hole 6" in diameter and down to your specified frost line. Ideally, holes will have a mushroom shape so they are flared out near the bottom. Pour mixed concrete into the hole to bring the depth to 12" below grade.
- Align the post centered with staked/markered location and slide the post into the hole. TIP: If the post is not centered, it will be off center when it sits at exactly 24" deep. Post height varies by fence system, so it may be helpful to pre-measure and mark posts or to measure exposed portion of post to use as a height reference.
- Add concrete to the hole to 3 1/2" below grade while holding the post centered. Place a few stones in the bottom of the hole to help hold the post in place.
- Repeat process for all additional posts. TIP: It may be helpful to lay out posts on the ground and then move them into the holes when they are concrete.
- Mark the location of gate(s) by placing a stake at each post. Fence gates are 47" wide and require a space of 48" between posts, so 3' posts should measure 51" from center to center. Fence gates cannot be racked and hinges must align, so the posts on each side of gates must be plum and level with each other. (Dia. 2)

FOR SURFACE MOUNT POSTS:

- For residential deck applications, pre-drill through deck boards and into board with a 3/16" diameter. Residential concrete applications, pre-drill and use with concrete anchors. For all other surfaces, check local zoning and/or building codes or consult a licensed professional.
- Level and plumb post using shims.
- Secure posts to surface with suggested screws. (Dia. 5)
- Do not install post caps until all fence panels are installed.

C PREPARE POSTS

- For all sides of posts which will hold a fence panel, measure 3 1/16" from ground/surface and place a pencil mark for the location of the lower attach clip. (Dia. 4) TIP: Set the panel in at a slight angle, reach through the pickets and pull open the bottom channel by hand and slide it onto the lower attach clips.
- Slide lower channel of pre-cut panel down onto lower attach clips (Dia. 9). TIP: Set the panel in at a slight angle, reach through the pickets and pull open the bottom channel by hand and slide it onto the lower attach clips.
- Measure between posts at the top edge of the panel. (Dia. 10)
- Cut Fence Caps 1/16" less than opening size.
- Clean cut areas and apply touch-up paint on exposed ends.

D INSTALL GATE(S)

After concrete has set, start the installation of fence panels at an end or corner post. If installing a gate, it is recommended to install that first, then work out from there.

1. Clean or hold fence panel against post and adjust for equal end spacing.

2. Mark the upper and lower channels.

3. Cut fence panel 1/16" less than opening size.

4. Clean cut areas and apply touch-up paint on exposed ends.

E MARK AND CUT FENCE PANELS

After concrete has set, start the installation of fence panels at an end or corner post. If installing a gate, it is recommended to install that first, then work out from there.

1. Confirm posts on both sides of gate are centered with staked/markered locations, level with each other, and measure 51" from center to center (or 48" inside measurement). (Dia. 3)

2. The fence panel height must be cut down to match the height of the fence posts (Dia. 7).

3. Install the gate hinges following the instructions provided in hinge package. Gate hinge instructions with 16 self-tapping screws. It is recommended to use 10 1/2" long screws for 6' panels and 10 1/4" long screws for 5' panels. These also include a flat washer, split lock washer, and nut for use on the backside. When using this hardware, mark and pre-drill all holes. When installing the hinge, use a screwdriver to turn the lock washer clockwise to lock the hinge. Do not over-tighten the screw.

4. Install the gate latch following the instructions provided in latch package.

The diagrams and instructions in the brochure are for illustration purposes only and are not meant to replace a licensed professional. Any construction or use of the product must be done with all local zoning and/or building codes and regulations. The manufacturer or contractor should take all necessary steps to ensure the safety of everyone involved in the use of the product. The manufacturer or contractor shall not be liable for any other warranty, either express or implied, and shall not be liable for any damages, including consequential damages.

322 - Version 1.1 - part #WWP401000

© 2024 - All rights reserved. The fence panel shown is for illustration purposes only and is not a representation of the actual product.

DO NOT attempt to assemble panels if parts are missing or damaged.

DO NOT attempt to assemble panels if parts are missing or damaged.

Drawn by L.J.G.
Checked by P.D.C.
Revised on ADDENDUM #2 - 6.28.2024

SEPARATOR ROW™ SPECIFICATIONS:

GENERAL:

1. CULTEC'S SEPARATOR ROW IS USED AS AN INEXPENSIVE MEANS OF REMOVING TOTAL SUSPENDED SOLIDS FROM THE CHAMBER SYSTEM, AS WELL AS PROVIDING EASIER ACCESS FOR INSPECTION AND MAINTENANCE.

2. THE SEPARATOR ROW PERFORMANCE SHALL BE TESTED AND VERIFIED TO THE PROTOCOLS AND PROCEDURES AS DEFINED BY ENVIRONMENTAL TECHNOLOGY VERIFICATION (ETV) CANADA TO ACHIEVE 80% TSS REMOVAL.

INSTALLATION:

A SEPARATOR ROW IS INSTALLED ON A 1-2 INCH [25-51 MM] WASHED, CRUSHED STONE BASE, TYPICALLY, THE CULTEC CHAMBER MODEL USED FOR THE SEPARATOR ROW IS THE SAME CHAMBER USED THROUGHOUT THE ENTIRE CHAMBER SYSTEM.

STORMWATER IS DISTRIBUTED TO THE SEPARATOR ROW BY A PRIMARY FEED SYSTEM THAT DIVERTS FLOW TO THE SEPARATOR ROW AND A SECONDARY BYPASS FEED SYSTEM THAT DIVERTS FLOW TO THE CATCH BASIN OR OTHER PARTS OF THE UNDERGROUND STORMWATER MANAGEMENT SYSTEM. THE DISTRIBUTION SYSTEM MAY BE BY PIPES SET TO A LOWER ELEVATION THAT PERMIT THE FIRST FLUSH TO THE SEPARATOR ROW VERSUS OTHER PARTS OF THE UNDERGROUND STORMWATER SYSTEM. THIS INITIAL FLOW MAY BE MANAGED BY A BAFFLE OR WEIR. THE SIZING OF THE PIPE(S) THAT PROVIDE STORM WATER TO THE SEPARATOR ROW IS TO BE DETERMINED BY THE DESIGN ENGINEER AND IS BASED UPON THE REQUIREMENT TO ACCOMMODATE THE DESIGN FLOW AND SERVICE CONVENIENCE.

THE CHAMBERS UTILIZED IN THE SEPARATOR ROW ARE TO BE COMPLETELY WRAPPED WITH CULTEC NO. 4800 WOVEN GEOTEXTILE. THIS CREATES A PASS-THROUGH FILTER ARRANGEMENT TO SEPARATE TOTAL SUSPENDED SOLIDS IN THE TRANSFER OF STORM WATER TO OTHER CHAMBERS THROUGHOUT THE UNDERGROUND STORMWATER MANAGEMENT SYSTEM.

ONCE WRAPPED, THE SEPARATOR ROW IS TO THEN PLACED ENTIRELY OVER 1 LAYER OF CULTEC NO. 4800 WOVEN GEOTEXTILE. THIS WOVEN GEOTEXTILE PROVIDES A DURABLE SURFACE WITHIN THE ROW FOR MAINTENANCE PROCEDURES AS WELL AS TO PREVENT ANY SCOURING OF THE STONE BASE DURING HIGH PRESSURE JETTING.

THE RECOMMENDED INSTALLATION OF SEPARATOR ROW CHAMBERS, IN REGARD TO STONE SEPARATION AND STONE ABOVE THE UNIT, ALONG WITH OTHER MINIMUM BURIAL MATERIALS AND METHOD SPECIFICATIONS DETAILED FOR THE PROPER INSTALLATION, IS THE SAME AS CULTEC'S REQUIREMENT DETAILED IN THE COMPANY'S INSTALLATION GUIDELINES WITH THE EXCEPTION OF THE PLACEMENT OF THE REQUIRED FILTERING FABRICS. PLEASE REFER TO CULTEC'S CURRENT INSTALLATION INSTRUCTIONS FOR STORMWATER CHAMBERS AS A GUIDE.

MAINTENANCE PROCEDURES:


CULTEC RECOMMENDS INSPECTIONS OF THE SEPARATOR ROW TO BE PERFORMED EVERY SIX MONTHS FOR THE FIRST YEAR. THE FREQUENCY OF INSPECTION CAN THEN BE ADJUSTED BASED UPON PREVIOUS OBSERVATION OF SEDIMENT DEPOSITION.

WHILE CLEANING IS POSSIBLE FROM A SINGLE MANHOLE IN SHORTER LINES, A CLEAN-OUT OPTION FROM EITHER END OF A LINE IS PREFERABLE, PARTICULARLY FOR LONGER RUNS. CLEANING INVOLVES FLUSHING SEDIMENT FROM THE BASE FABRIC OF THE SEPARATOR ROW.

ACCESS WILL BE PROVIDED VIA A MANHOLE(S) LOCATED AT THE END(S) OF THE ROW FOR CLEAN OUT.

MAINTENANCE OF THE SEPARATOR ROW IS TO BE ACCOMPLISHED WITH A JETVAC PROCESS.

THE JETVAC IS TO BE SENT DOWN THE ENTIRE LENGTH OF THE SEPARATOR ROW. AS THE HIGH PRESSURE WATER NOZZLE IS RETRIEVED, THE CAPTURED SEDIMENTS ARE PUSHED BACK INTO THE MANHOLE FOR VACUUMING.

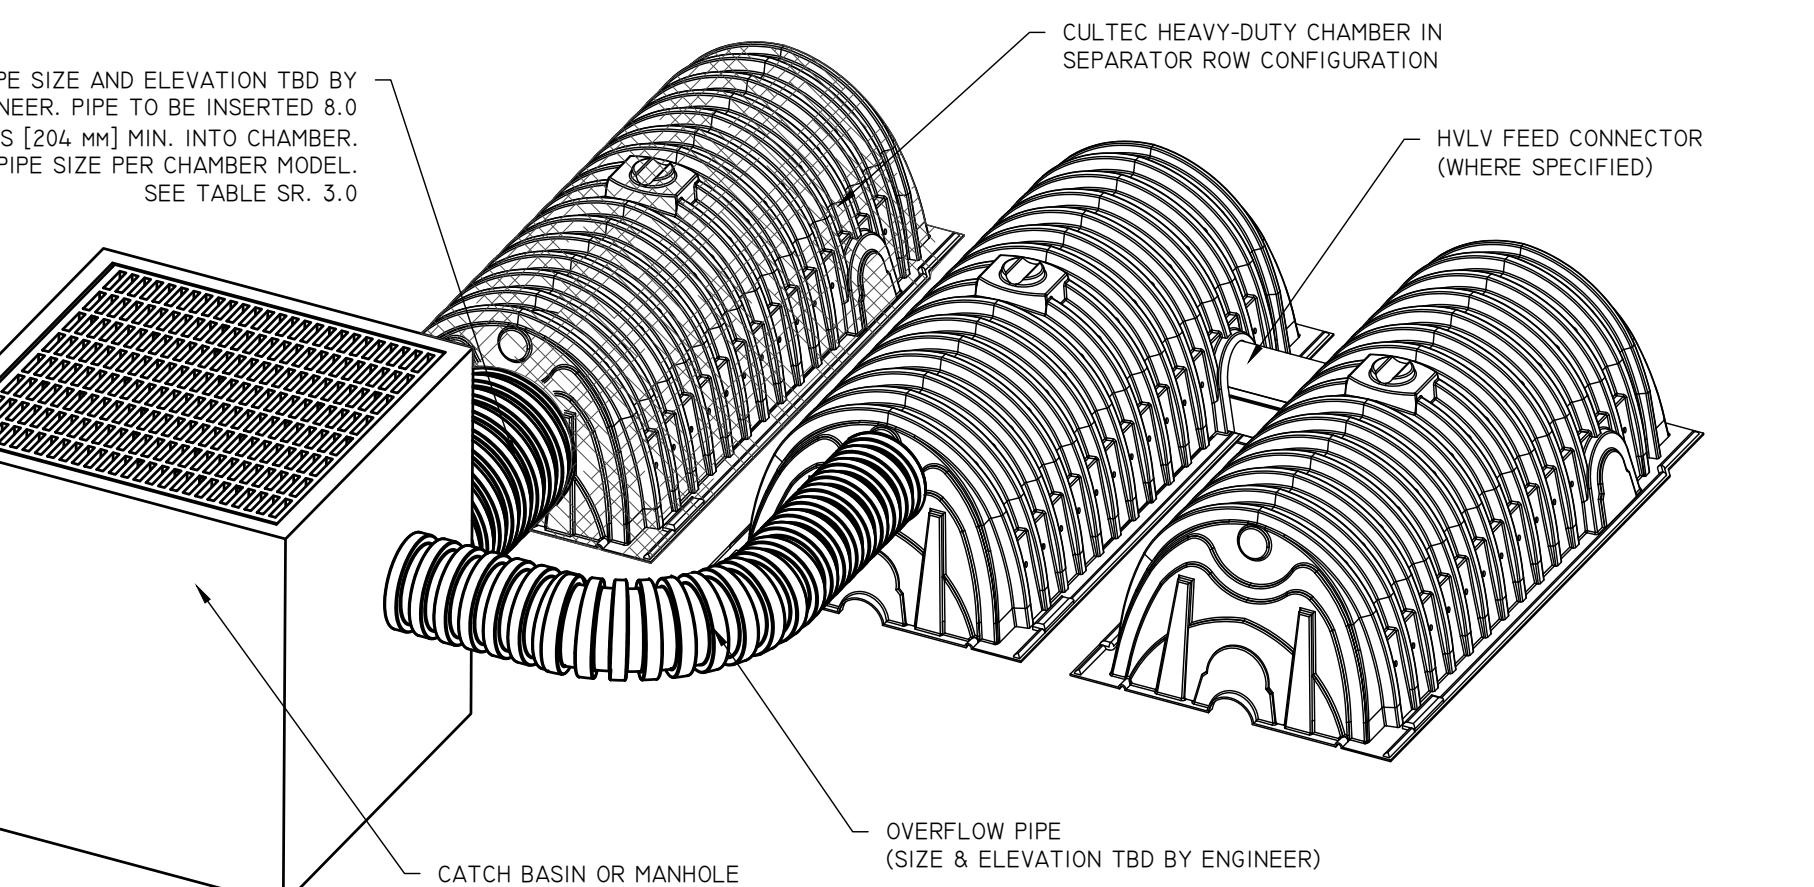

**TYPICAL SEPARATOR ROW CONFIGURATION
INLET CONNECTION DETAIL**


NOT TO SCALE

CULTEC CHAMBER MODEL						
	DESCRIPTION	CONTACTOR 100HD	RECHARGER 150XLHD	RECHARGER 280HD	RECHARGER 330XLHD	RECHARGER 902HD
A ¹	MIN. DEPTH OF STONE BASE	6"	6"	6"	6"	9"
		152 mm	152 mm	152 mm	152 mm	229 mm
B	CHAMBER HEIGHT	12.5"	18.5"	26.5"	30.5"	48"
		318 mm	470 mm	673 mm	775 mm	1219 mm
C ¹	MIN. DEPTH OF STONE REQUIRED ABOVE UNITS FOR TRAFFIC APPLICATIONS	6"	6"	6"	6"	12"
		152 mm	152 mm	152 mm	152 mm	305 mm
D	MIN. DEPTH REQUIRED OF 95% COMPACTED FILL FOR PAVED TRAFFIC	8"	8"	8"	10"	12"
		203 mm	203 mm	203 mm	254 mm	305 mm
E	MAX. DEPTH OF COVER ALLOWED ABOVE CROWN OF CHAMBER	12'	12'	12'	12'	8.3'
		3.65 m	3.65 m	3.65 m	3.65 m	2.53 m
	MAX. PIPE SIZE TO CHAMBER ENDWALL/ENDCAP	10"	12"	18"	24"	24"
		250 mm	300 mm	450 mm	600 mm	600 mm

NOTE: STONE ABOVE AND BELOW UNITS MAY VARY PER SYSTEM. SEE SYSTEM LAYOUT FOR STONE REQUIREMENTS


CROSS SECTION TABLE REFERENCE

NOT TO SCALE

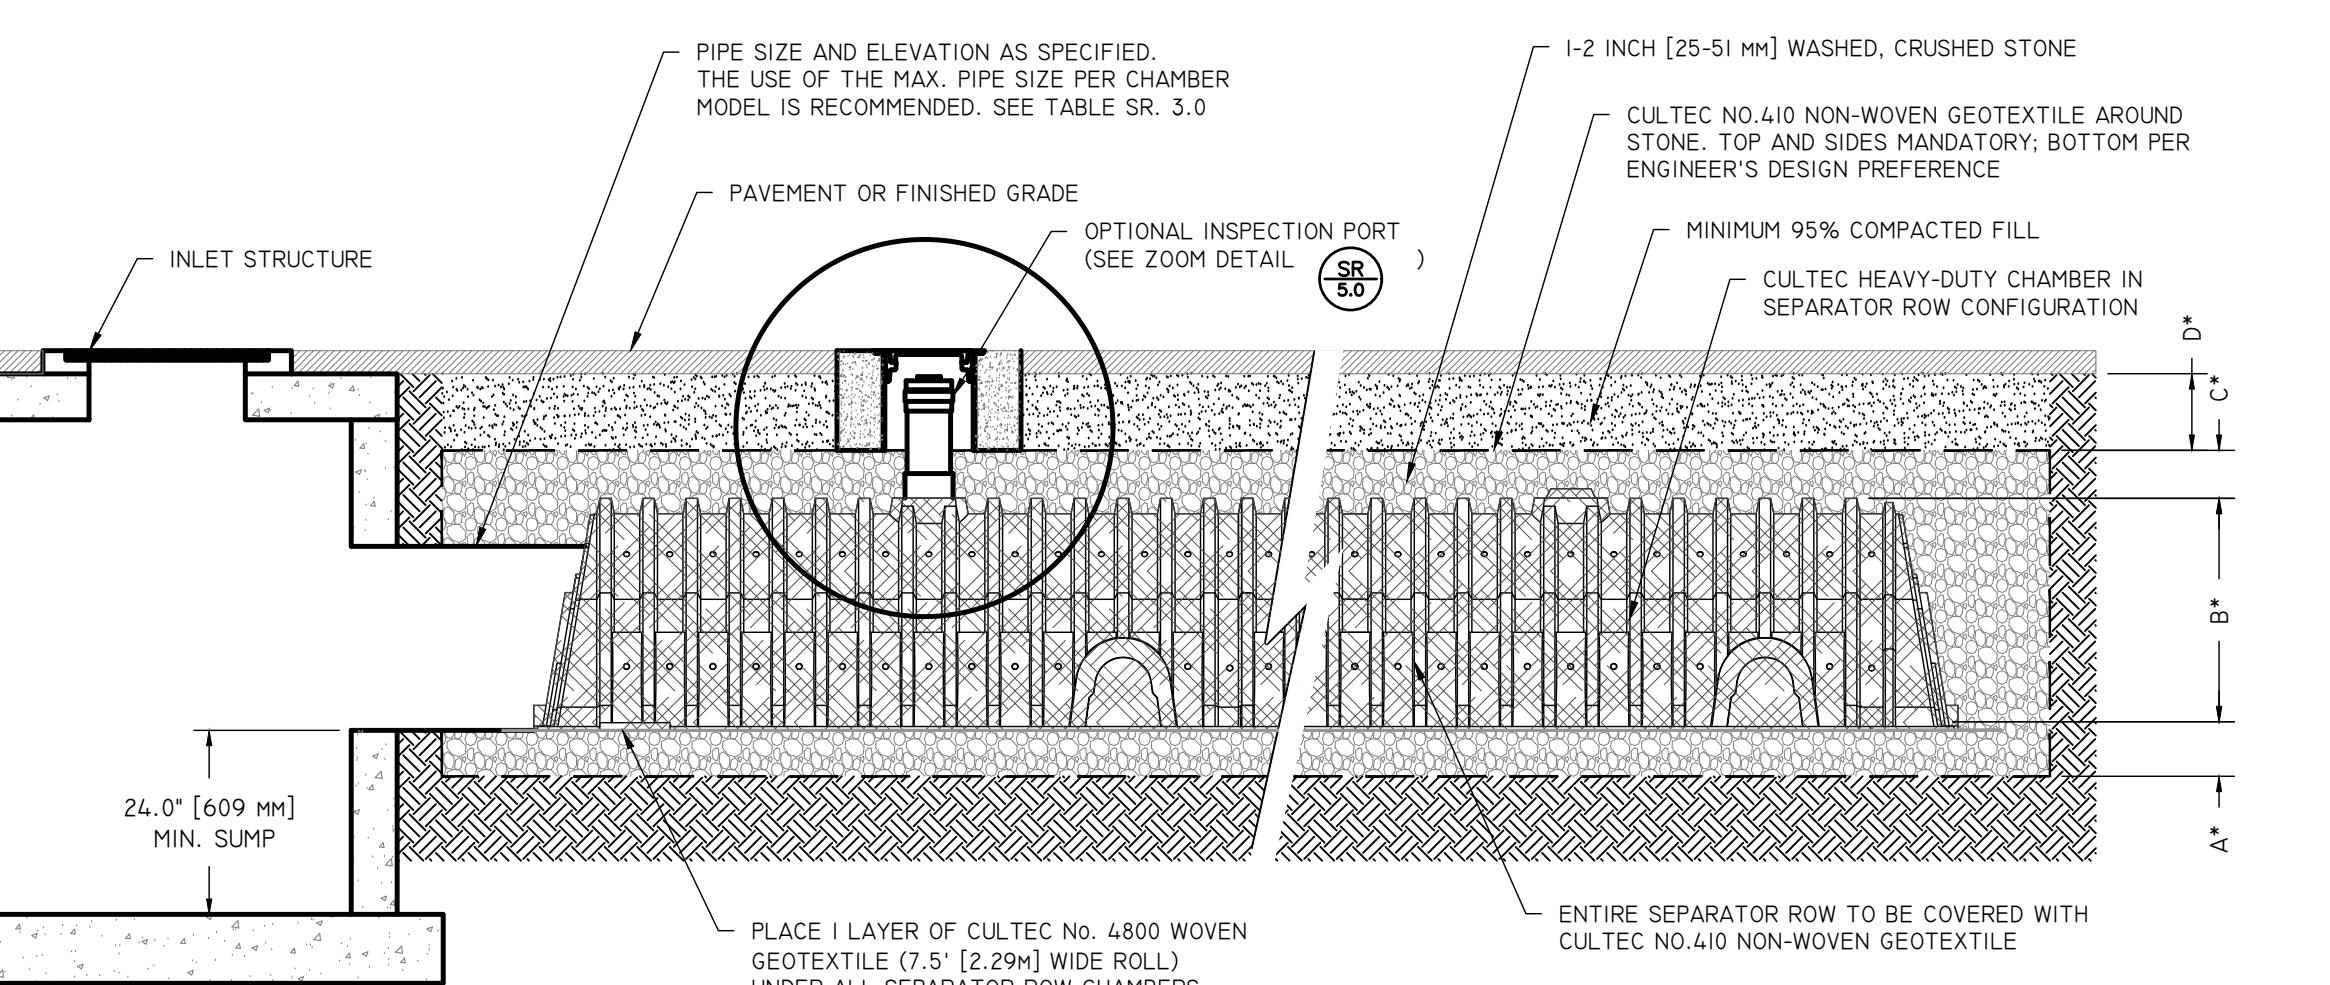


**TYPICAL SEPARATOR ROW CONFIGURATION CROSS SECTION WITH
INSPECTION PORT DETAIL**

NOT TO SCALE

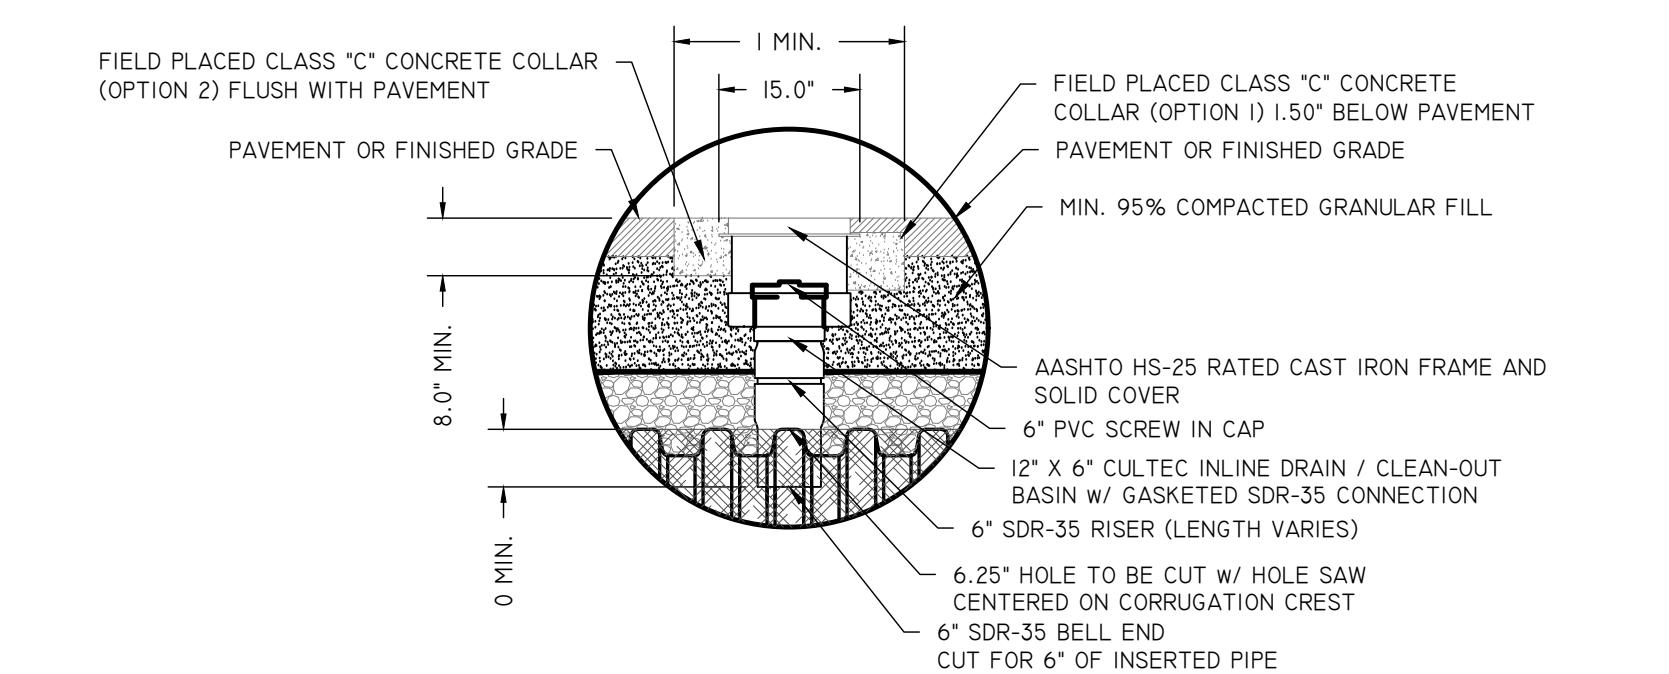


TYPICAL INSPECTION PORT - ZOOM DETAIL

NOT TO SCALE

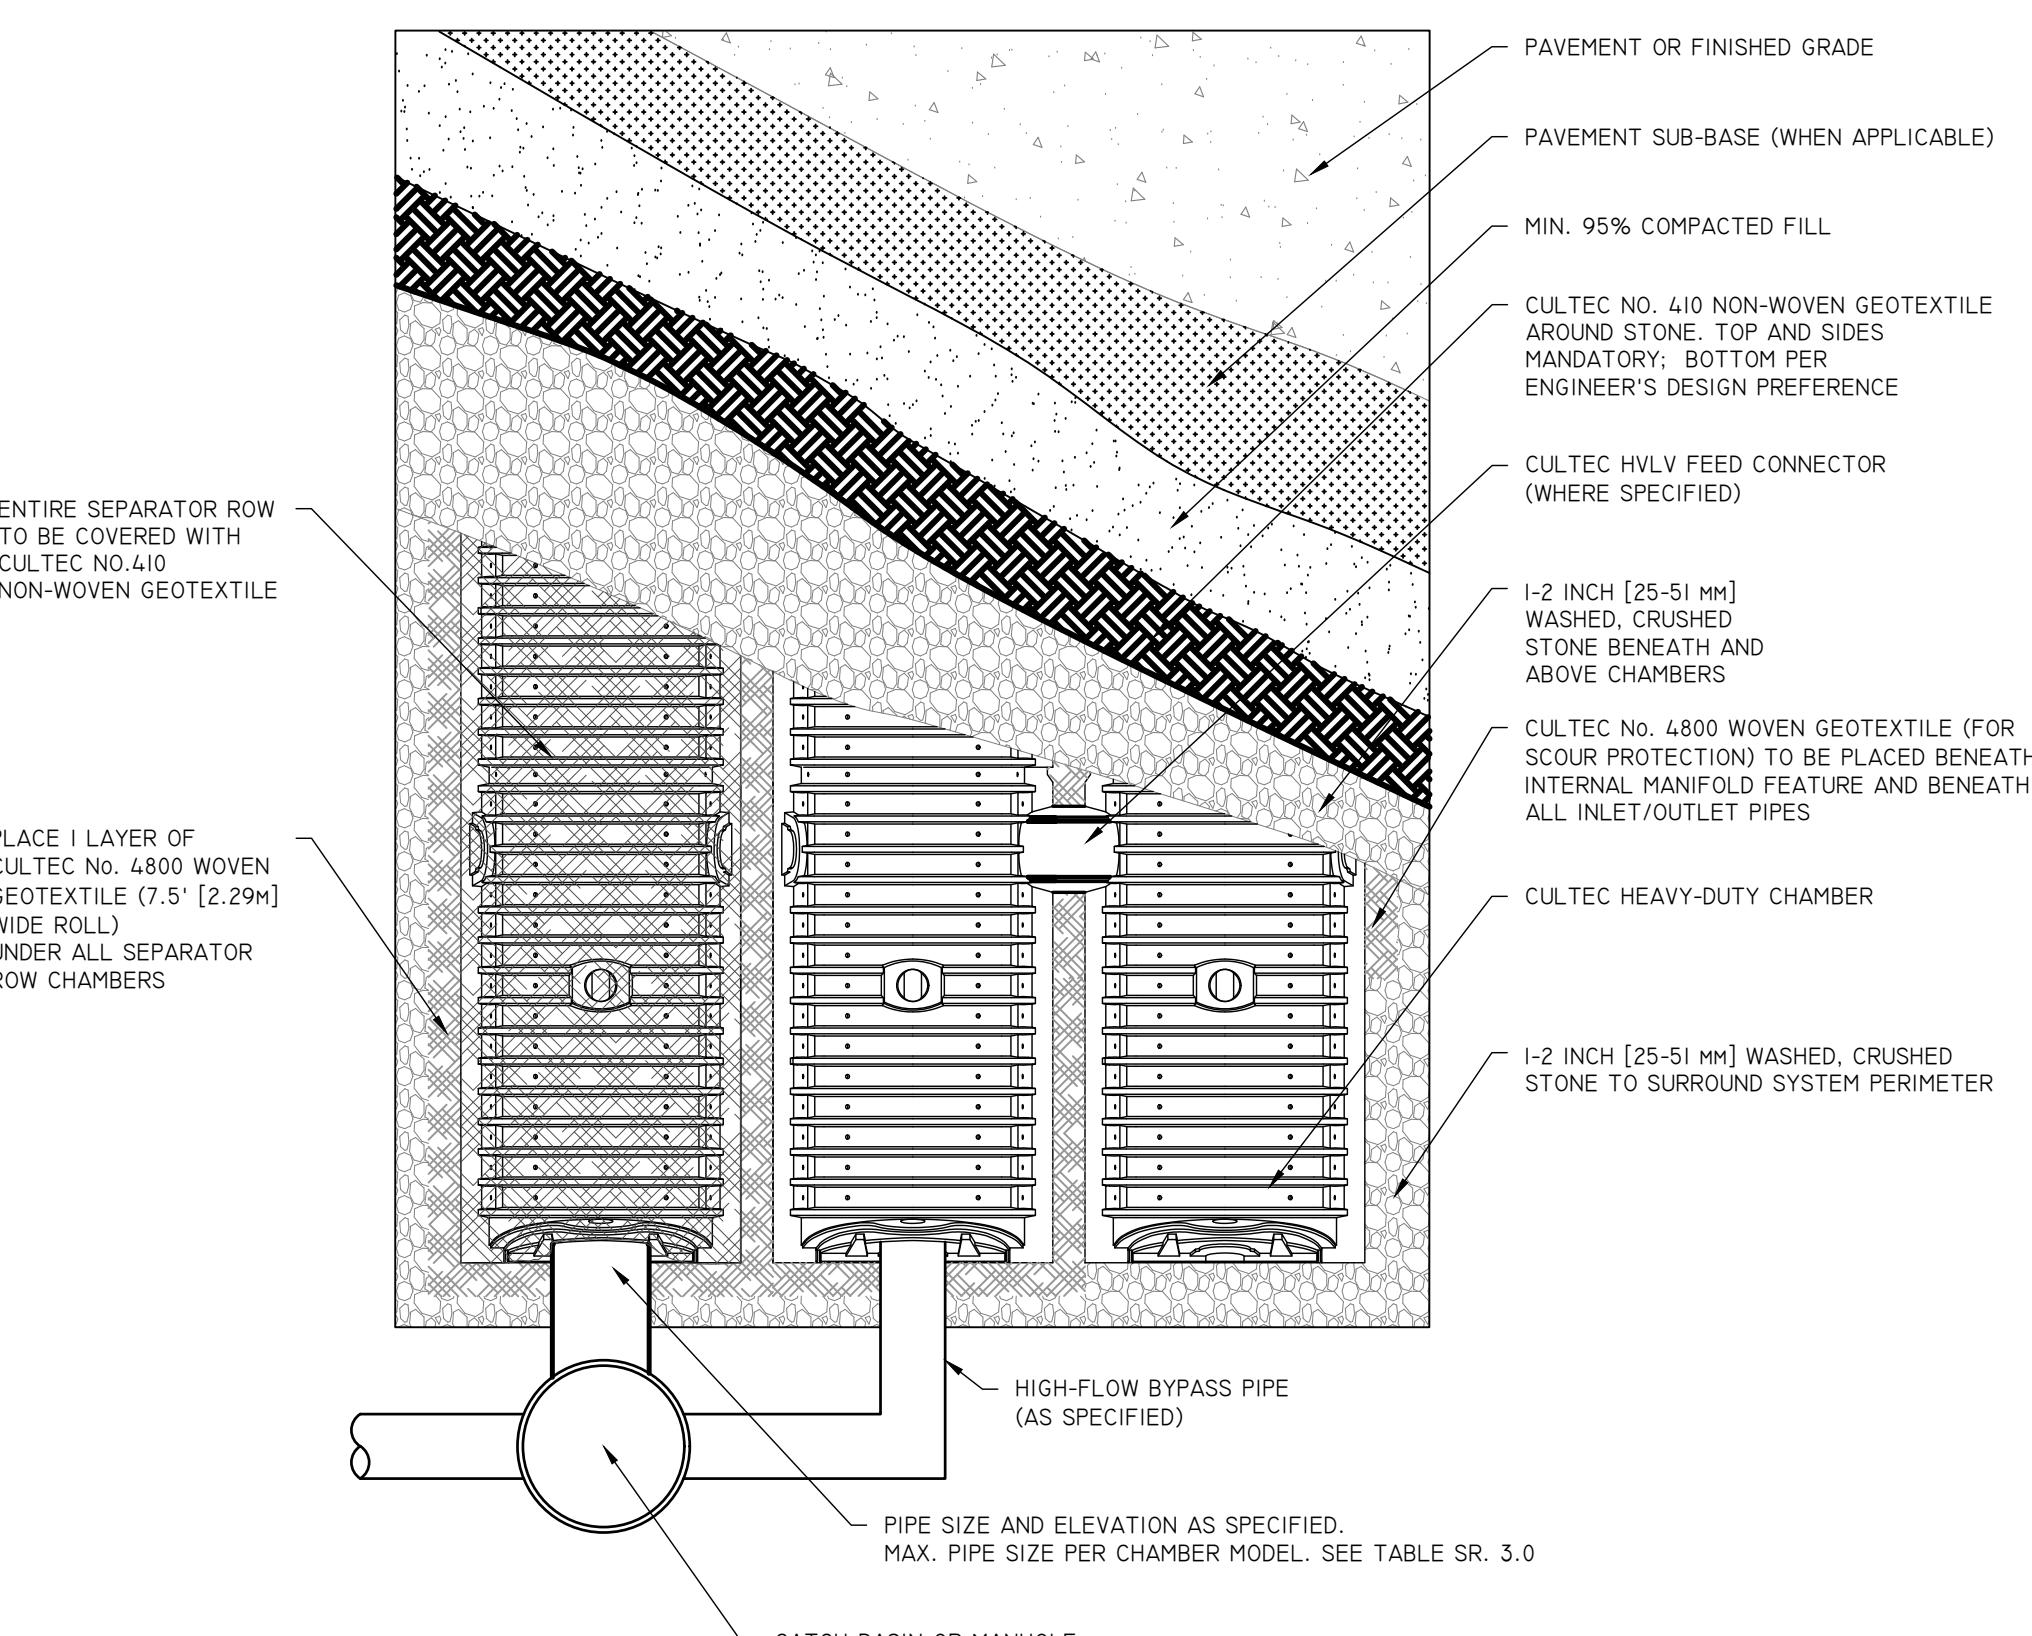

**TYPICAL SEPARATOR ROW CONFIGURATION
PLAN VIEW**

NOT TO SCALE

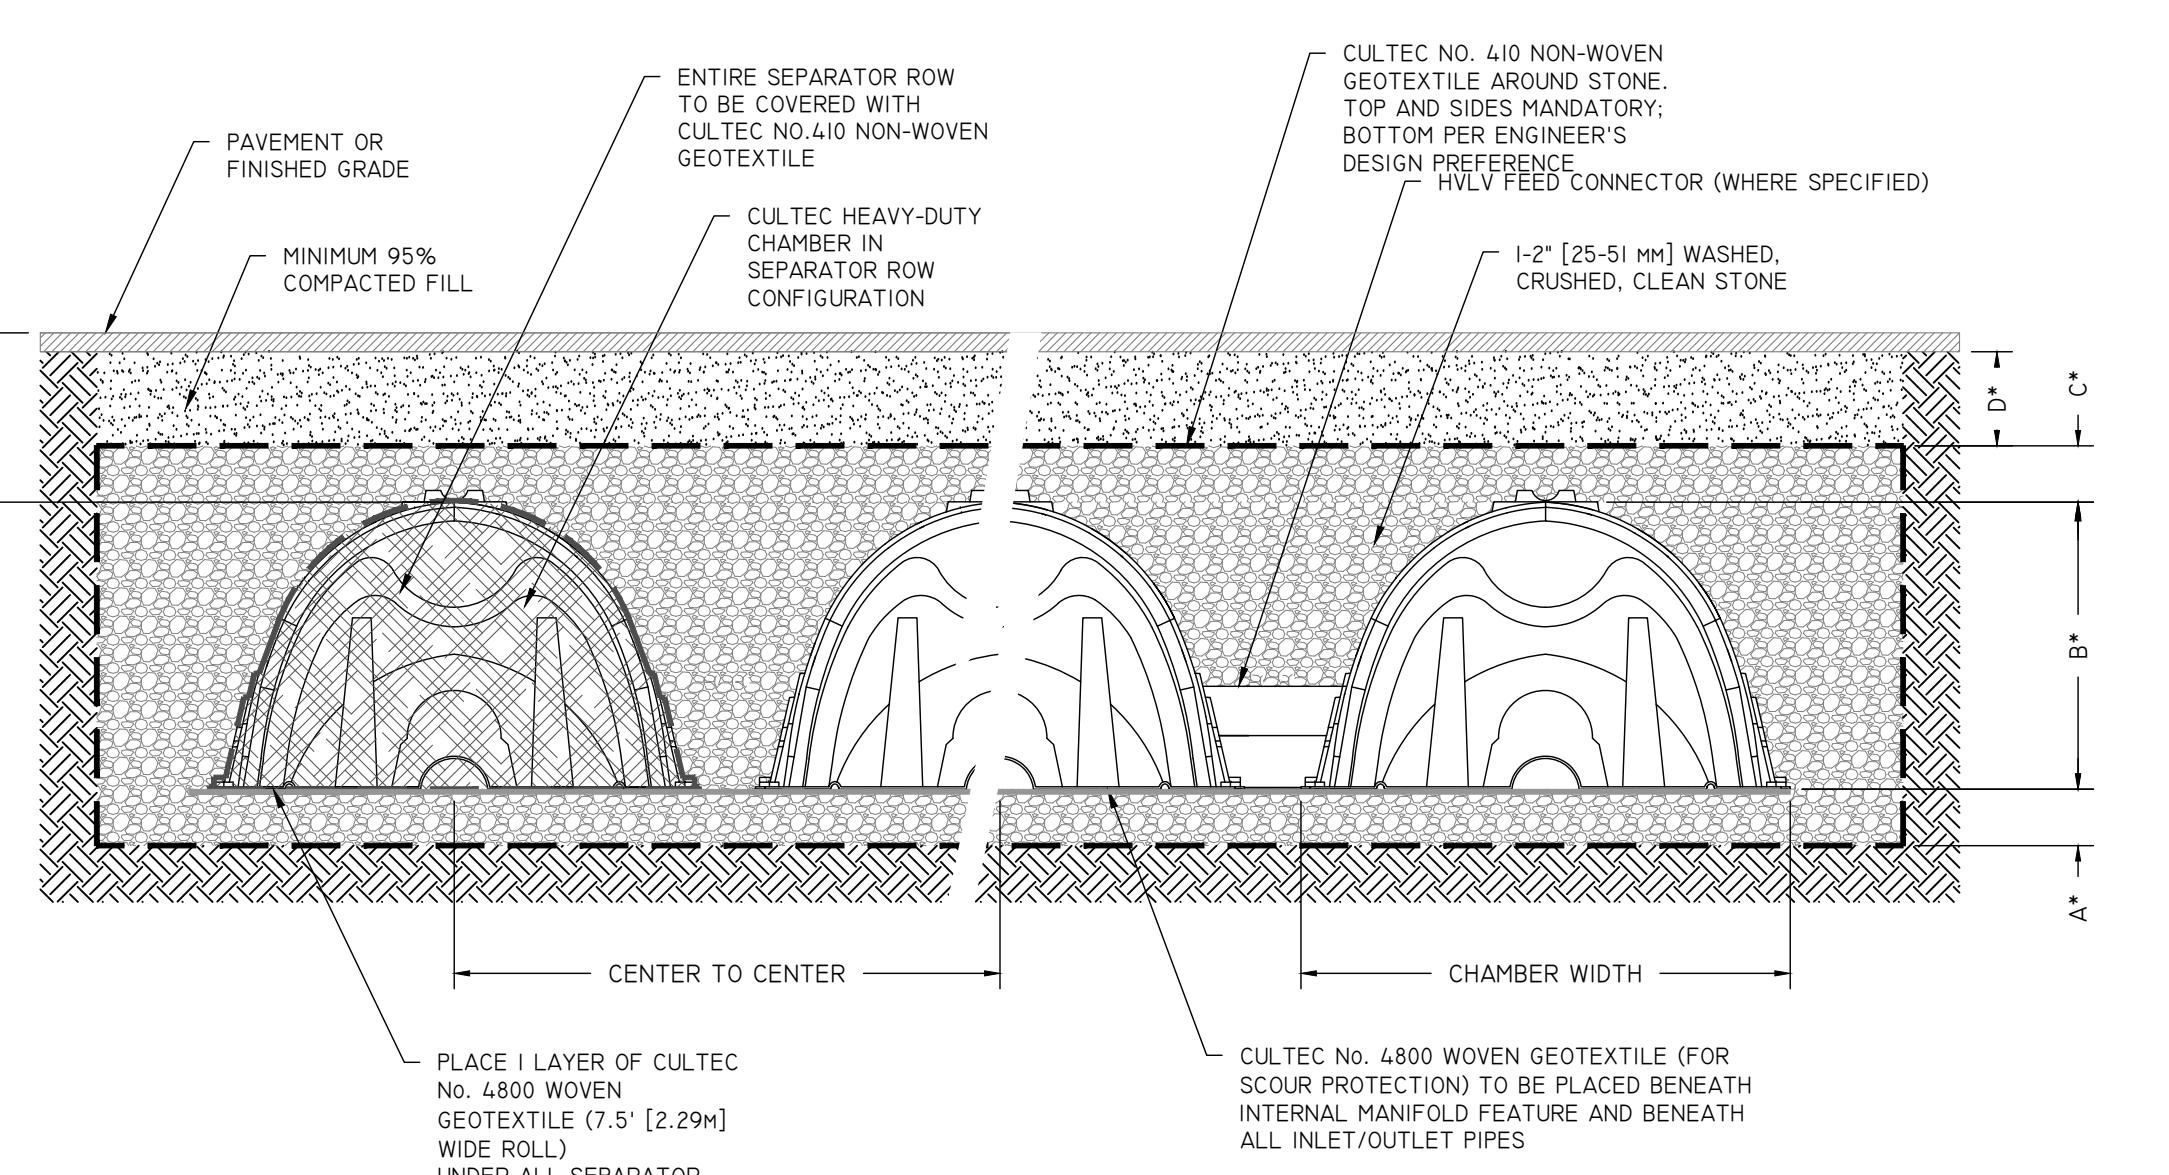

TYPICAL SEPARATOR ROW CONFIGURATION CROSS SECTION

NOT TO SCALE


50 Holden Street
Providence, Rhode Island 02908
Phone: (401) 272-7730
Fax: (401) 273-156
E-mail: rgbinfo@rgb.net
www.rgben.com

Architecture - Project Management - Interior Design

Project

**DEDHAM-
WESTWOOD
WATER DISTRICT**

**STORAGE
FACILITY**

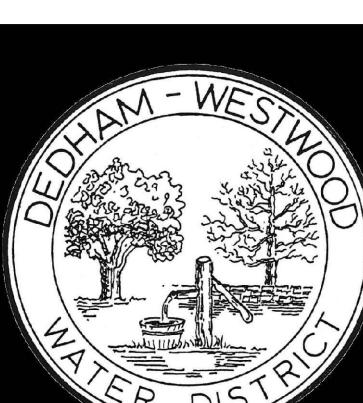

50 ELM STREET
DEDHAM, MA 02026

Drawing Status
**100% CONSTRUCTION
DOCUMENTS**

Issued On 6/28/2024

Sheet Contents
**DETAIL SHEET
(3 OF 3)**


Project Number. 6790

Drawing No. C008

Sheet 8 of 8


ABBREVIATIONS

AFF	ABOVE FINISHED FLOOR	FLU	FLUORESCENT	OSB	ORIENTED STRAND BOARD	VI	VIBRATION ISOLATOR	WID	WIDE, WIDTH
AFP	ACCESS PANEL	FL	FLOW LINE	OAE	OR APPROVED EQUAL	VIF	VERIFY IN FIELD	WFUF	WIDE-FLANGE BEAM
ACP	ACCESSORY ACCESSORIES	FT	FOOT, FEET	OD	OUTSIDE DIAMETER	VNL	VINYL	WG	WIRE GLASS
ACOUS	ACOUSTICAL	FO	FOOTSTLLES	OA	OVERALL	VCT	VINYL COMPOSITION TILE	WM	WIRE MESH
ACT	ACUSTIC CEILING TILE	FTG	FOOTING	OH	OVERHEAD	VB	VINYL BASE	W/W	WITH
ADH	ADHESIVE	FWD, FDW	FOUNDATION (WALL)	OHB	OVERHEAD BRACED	VFT	VINYL FABRIC	W/OUT	WITHOUT
ADJ	ADJUSTABLE	FR	FRAMING (ING)	OHD	OVERHEAD DOOR	VS	VINYL SHEET	WD	WOOD
AGG	AGGREGATE (S)	F&I	FURNISH & INSTALL	OIT	OWNER INSTALLED & INSTALLED	VIT	VINYL TILE	WB	WOOD BASE
A/C	AIR/VEAPOR BARRIER	FUR	FURNISH & INSTALL	OFCI	OWNER FURNISH-CONTRACTOR INSTALL	VC	VITREOUS	WBO	WORK BY OTHERS
AVB	AIR/VEAPOR BARRIER	FUT	FUTURE	OFG	OWNER FURNISHED & INSTALLED	VG	VITREOUS CLAY	WBO	WORK BY OWNER
ALT	ALTERNATE	FUTR	FUTURE	OFT	OWNER FURNISHED- & INSTALLED	VH	VITREOUS	WBT	WORK BY TENANT
ALM	ALUMINUM	FUS	FUSED	OFCI	OWNER FURNISH-CONTRACTOR INSTALL	VVC	VINYL WALLCOVERING	WK	WORK
AT	ALUMINUM-FRESHOLD	FUSP	FUSED REFORSED PLASTIC	OX	OXYGEN	VV	VINYL WALLCOVERING	WKR	WORKROOM
ANC	ANCHOR (S) ANCHORAGE (S)	FSL	FUSED LINK	PT	PRESSURE TREATED	WN	WAISCOT	WI	WROUGHT IRON
AB	ANGLE	GAL	GALLON (S)	PR	PAINT, PAINTED	WH	WALL-HUNG		
ANOD	ANODIZED	GPH	GALLONS PER HOUR	PR, //	PAINT, PAINTED	WHY	WALL-MOUNT		
ANT	ANTENNA (E)	GPM	GALLONS PER MINUTE	PRD, //	PARALLEL	WTW	WALL-TO-WALL	XR	X-RAY
APP	APPROVED APPROVAL	GPS	GALLONS PER SECOND	PBD	PARTICLE BOARD	W	WASTE		
APPROX	APPROXIMATE	GALV	GALVANIZED	PF	PERCENT (%)	WAC	WALL-RECEPTACLES	Y	WEY FITTING
APRT	ACOUSTICAL PARTITION	GI	GASKET (ED)	PCT	PERCENT (AGE)	WCA	WATER CLOSET		
AD	AREA DRAIN	GST	GATE VALVE	PF	PERFORATED (D)	WHA	WATER HAMMER ARRESTOR	Z	ZONE
@	ATTACH, ATTACHMENT	GAV	GAUZE	PERP,	PERPENDICULAR	WP	WATERPROOF (ED), (ING)	ZD	ZINC-COATED
ALD	AUTOMATIC LOUVER DAMPER	GCA	GLASS	PERP,	PERPENDICULAR	WST	WEATHERSTRIPPING	ZS	ZEE STUD
AVE	AVENUE	GLB	GLASS BLOCK	PLAS	PLASTER	WE	WEEPHOLE		
AVG	AVERAGE	GMU	GLASS MASONRY UNITS	PLUM	PLUMBER	WWF	WELDED WIRE FABRIC		
BTB	BACK TO BACK	GR	GRADE, GRADING	PNL	PNEUMATIC				
BM	BEAM	GRD	GRADE, GRADING	POL	POLISH (ED)				
BK	BENCH MARK	GRT	GRANITE	PR	PORE, PORE ENAMEL				
BG	BEARING	GRILLE	GRILLE	PSL	POUNDS PER LINEAR FOOT				
BT	BOTTOM OF CURB	GD	GROUND (ED)	PSL	POUNDS PER SQUARE INCH				
BLK	BLOCK	GTP, BD	GYPSUM WALLBOARD	PC	POURED INPLACE CONCRETE				
BLKG	BOARDING	GWB	GYPSUM WALLBOARD	PDF	POWER DRIVEN FASTENER (ING)				
BD	BOTTOM OF FOOTING	GYL	GYPSUM LATH	PFC	PREFABRICATED				
BO	BOTTOM OF	GPRC	GYPSUM REINF. CONC.	PRF	PREFINISH (ED)				
BOC	BOTH SIDES	GPL	GYPSUM PLASTER	PRM	PREMOLDED				
BS	BOTH WAYS	HH	HAND HOLD	PMTL	PRESSED METAL				
BW	BOTH WAYS	HA	HANGER	PT	POLE, POLE				
BTOT	BRACKET	HB	HBARD	PTD	PROJECT				
BKT	BRICK	HC	HANDICAP(ED)	PTYL, //	PROPERTY LINE				
BKG	BUILDING	HD	HEAD	PUB	PUBLIC ADDRESS SYSTEM				
BLDG	BUILT-UP ROOFING	HD	HEADER	PA	PULL BOX				
BUR	CHALK	HDR	HEAT DETECTOR	PB	PULL, PULL CHAIN				
CK	CABINET	HDE	HEAT	PP	PUMP				
CBT, CAB	CABINET	HAC	HEATING & AIR CONDITIONING	PD	PUMP DISCHARGE				
CF	CAST IRON	H&V	HEATING, VENTILATING & AIR CONDITIONING	PIV	POST INDICATOR VALUE				
CL	CATCH BASIN	HVAC	HEATING, VENTILATING, COOLING	PC	PHYSICALLY CHALLENGED				
CLG	CEILING	HV	HIGH VOLTAGE	PCV	POLE, VINYL CHLORIDE				
CL, CL	CENTER CENTER	HZ	HERTZ (CYCLES PER SECOND)	QT	QUADRANT TILE				
CT, CTC	CENTER-TO CENTER	HPL	HIGH-QUALITY LAMINATE	RAD	RADIATOR, RADIATION				
C	CERAMIC TILE	HW	HIGH VOLTAGE	RA, R	RADIUS				
CLF	CHAIN-LINK FENCE	HQ	HOLD	R, R	RISER				
CLB	CHILKAWARD	HWD	HOLLOW CORE WOOD	RAL	RAIL, RAILING				
CH, I	CHANNEL	HM	HOLLOW METAL DOOR	RECP	RECEPACIE				
CM	CENTIMETER	HMP	HOLLOW METAL FRAME	REF	REFLECTIVE				
CW	CHECK VALVE	HQK	HOOK (S)	REFB	REFER TO				
CHWR	CHILLED WATER SUPPLY	HR	HR, HORIZONTAL	RFC	REINFORCE (D) (ING)				
CHWS	CHILLED WATER SUPPLY	HPS	HORSEPOWER	RC	REINFORCED CONCRETE				
CKT	CIRCUIT	HSB	HOSE BIBB	REQ, REQD	REQUIRED, REQUIREMENTS				
CD	CLEAR OUT	HWT	HOT WATER	R&D	REMOVED & DISPOSE				
CLR	CLEAR, CLEARANCES	HWR	HOT WATER RETURN	R&R	REMOVED & REINSTALL				
CLS	CLOSURE	HWC	HOT WATER CIRCULATOR	RTN	RETAIN (ED) (ER) (ING)				
COL	COLLECTOR	HWF	HOT WATER FAUCET	RVS, REV	REVERSE (SIDE)				
COMP	COMPRESS (ED), (ION), (BLE)	HWT	HOT WATER HEATING	REV	REVISE, REVISED				
CONC	CONCRETE (PORTLAND CEMENT)	HWT	HOT WATER TANK	RPM	REVOLUTION PER MINUTE				
COND	CONDUIT	HYD	HYDRANT	RPS	REVOLUTIONS PER SECOND				
CX	CONNECTION	IN	INCH	RH	RIGHT HAND				
CONT	CONTRACT	INCL	INCLUDING (ED), (SIVE)	RH, R	RIGHT, RIGHT WAY				
CONTR	CONTRACTOR	INFO	INSIDE DIAMETER	RD	ROOF DRAIN				
CJ	CONTROL, JON	INSL	INSULATE (D) (ATION)	RFG	ROOFING				
CFL	COUNTERTOP, LASHING (S)	IMC	INSULATED METAL CLAD	RIM	ROOF				
CS	COUNTERSINK, COUNTERSUNK	INT	INTERNAL, INTERNAL	RO	ROUGH OPENING				
CU	CUBIC	INV	INVERT	RU	RUBBER				
CFM	CUBIC FEET PER MINUTE	IDM	INVERT ELEVATION	SD	SADDLE				
CFS	CUBIC FEET PER SECOND	ISDM	ISOLATE DISC, METALS	SAN	SANITARY (SEWER)				
CUIN	CUBIC INCH	JAN	JANITOR	SC	SCREW				
CYL	CYLINDER, CYLINDRICAL	JF	JOINT FILLER	SL	SEALANT				
DPR	DAMPER	JS	JOINT SEALER	SLR	SEALER				
DAMPROOF	(ED), (ING)	JCT	JOST	SEL	SELTING				
DL	DALE	JUNCTION	JUNCTION BOX	SEC	SECTION				
DB	DECIBEL	JB	JUNCTION	SEL	SELECT (OR)				
DEG	DEGREE	K	KNOCK DOWN	SPT	SEPTIC TANK				
DEM	DEMOLISH, DEMOLITION	KW	KILOWATT	SV	SERVICE				
DEP	DEPRESSED	KWAT	KILOWATTS	SSK	SERVICE SINK				
DET	DETACH	KP	KIP	SCWD	SMOKE DETECTOR				
DIA or Ø	DIA, Ø	KD	KNOCK DOWN	SSWD	SMOKE-VENTING HATCH				
DIM	DIMETER	L	LEAD	SSWM	SOLID CORE WOOD				
DC	DIRECT CURRENT	LAB	LADDER	SSM	SOLID SURFACE MATERIAL				
DX	DIRECT, DIRECT (ION)	LAM	LAMINATE (D)	SPK	SPEAKER				
DPN	DISPENSED	LAT	LATERAL	SPEC	SPECIFICATIONS				
DPL	DISPOSAL, DISPOSABLE	LAV	LAVATORY	SPR	SPRINKLER				
DR	DOOR	LBL	LABEL	SPR	SPRING				
DBL	DOUBLE	LBS, #	POUNDS	SPR	SPRING				
DHA	DOUBLE-HUNG	LOC	LOCATED	SPWD	SPUDDED				
DTA	DOVETAIL ANCHOR	LDR	LEADER	SPWD CEI	SPUDDED CEILING				
DTS	DOVETAIL ANCHOR SLOT	LH	LEFT-HAND	SYS	SYMMETRY (CAL)				
DN	DOWN	LWD	LESS WIDTH OF DOOR	SY	SYST				
DS	DOWNSPOUT	LIN	LINEN	TH	THICK, THICKNESS				
DI	DRAINAGE LINE	LP	LIGHT PROOF	THS	THRESHOLD				
DT	DRAIN INLET	LS	LIMESTONE	THS	THICK, THICKNESS				
DWG, DRWG	DRAWING	LTL	LITTLE	TOL	TOP, TOLERANCE				
DR	DRINKING FOUNTAIN	LL	LOW LOAD	TOL, T	TOP OF CONCRETE / CURB				
DMH	DROP MANHOLE	LW	LOW PRESSURE	TOS, TS	TOP OF STEEL				
EIFS	EXT. INSUL FINISH SYSTEM	LK	LOCKER	TOW	TOP OF WALL				

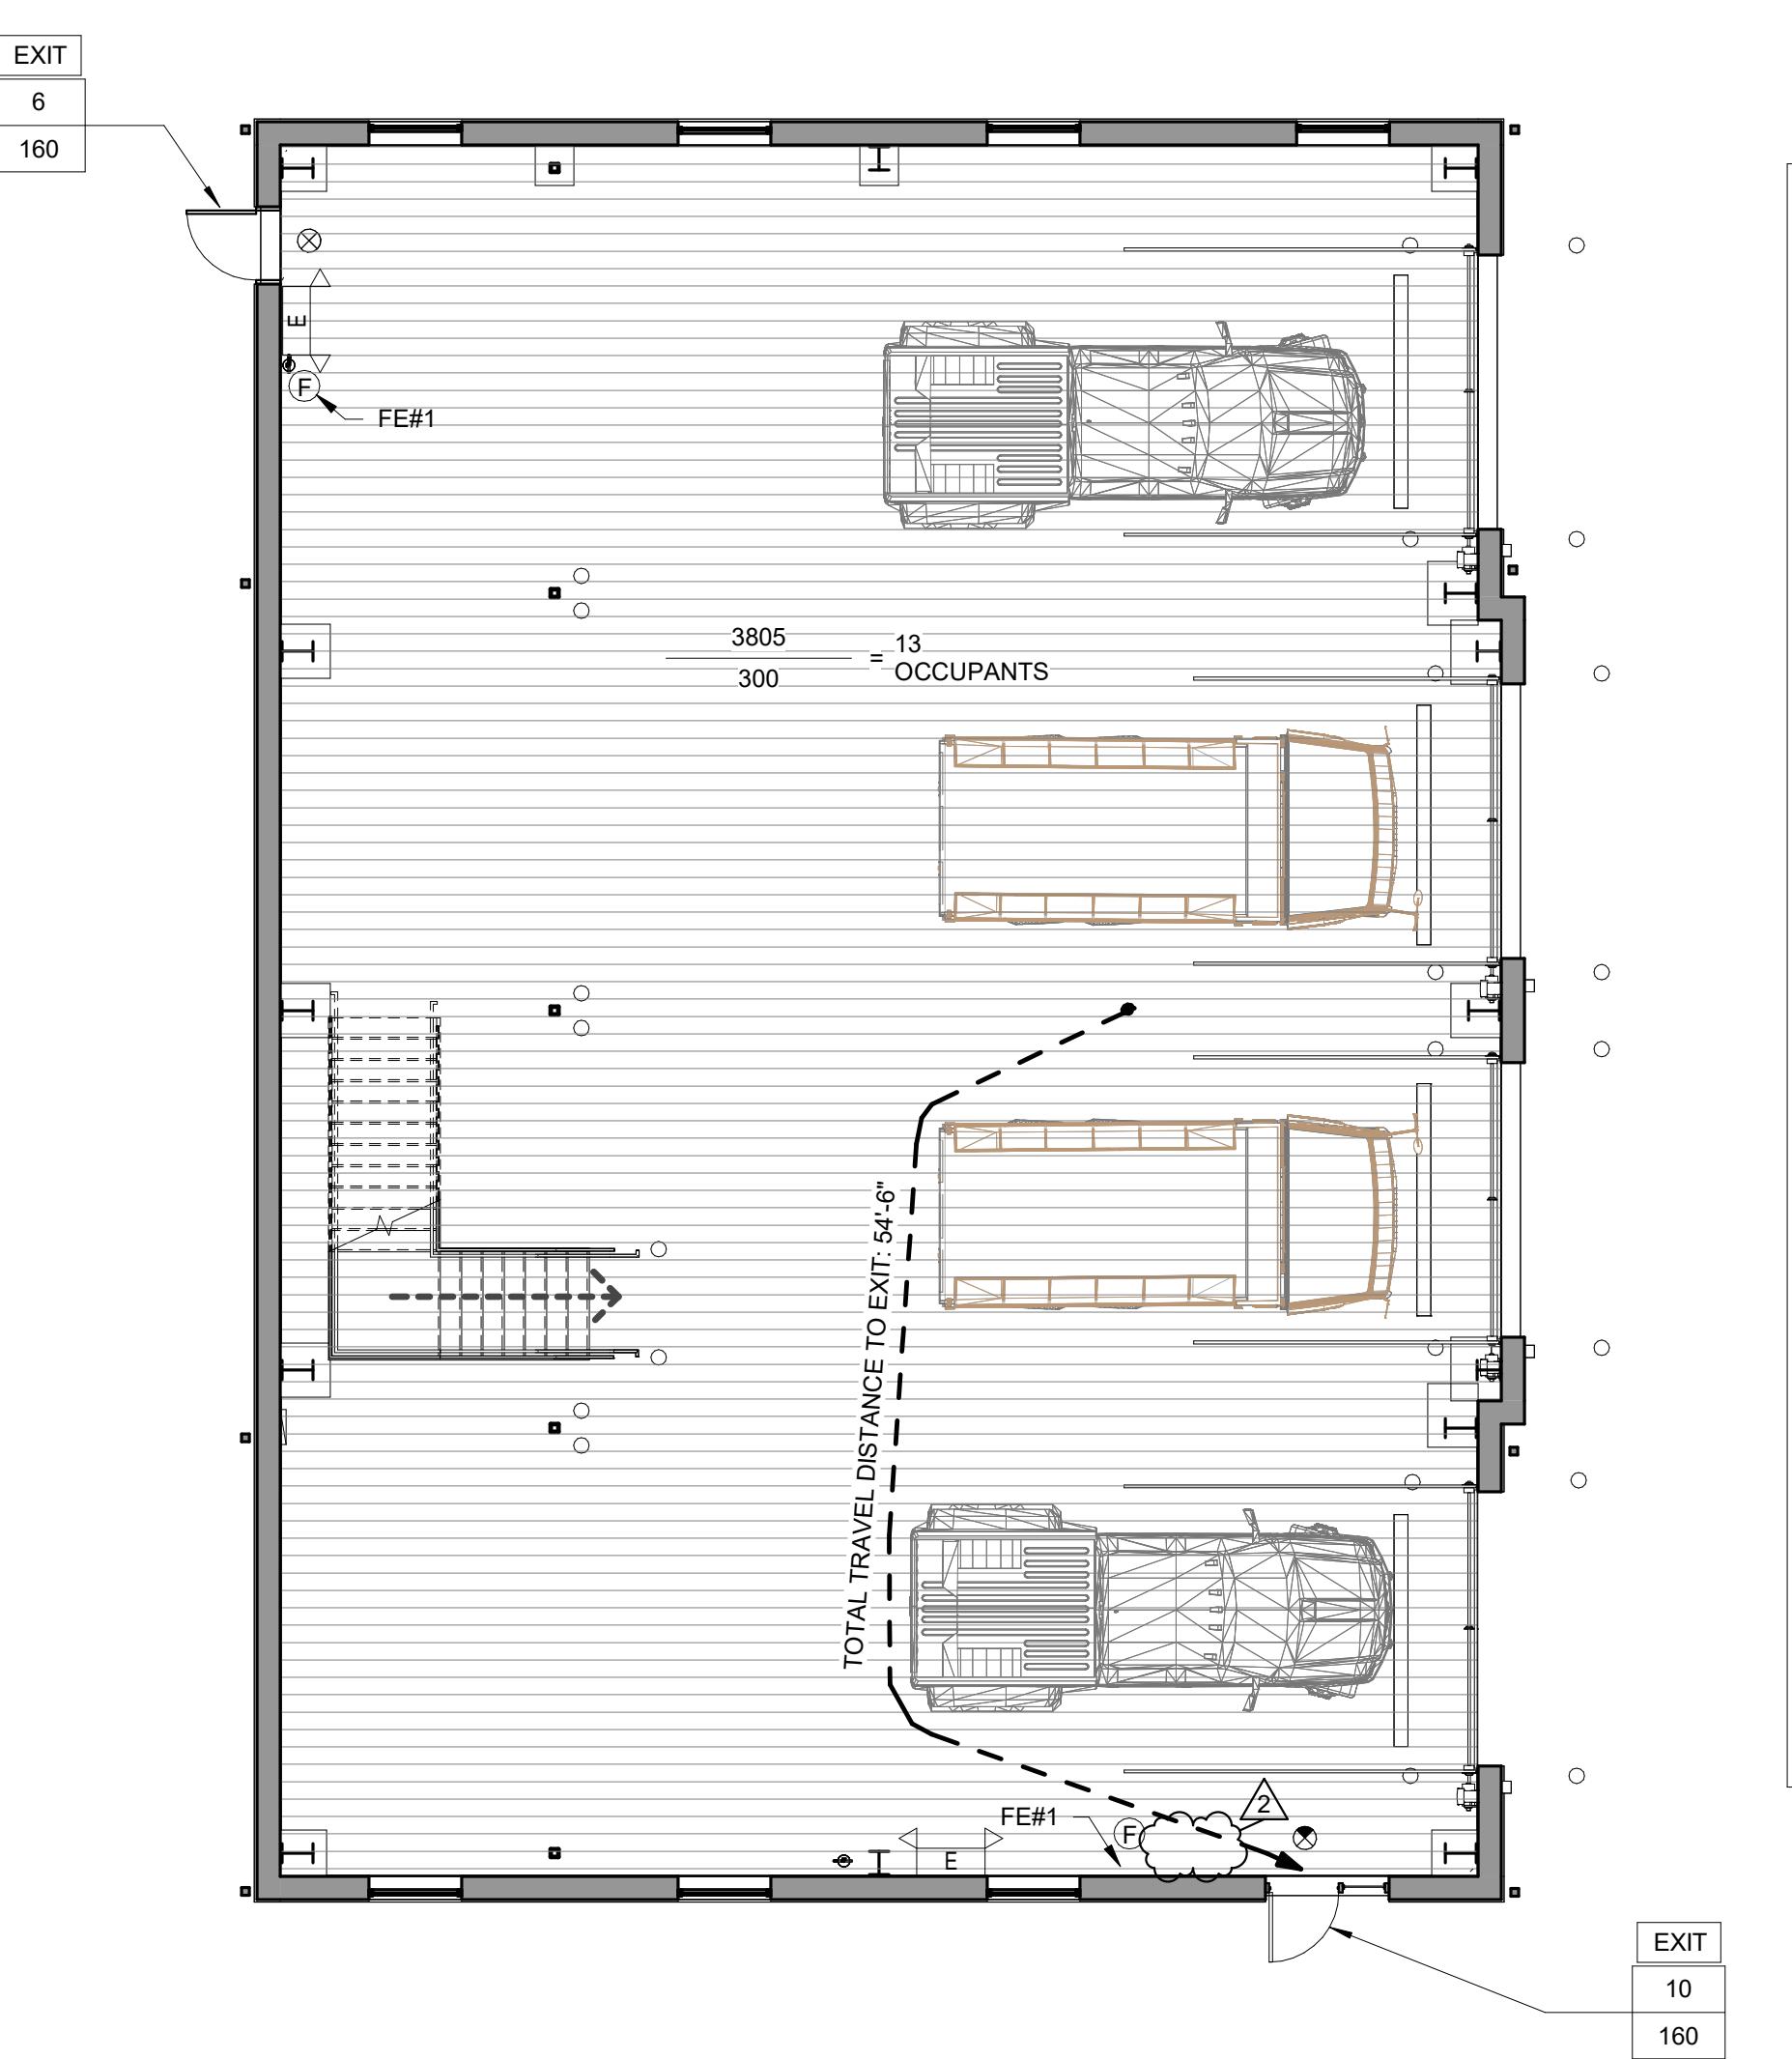


CODE REVIEW PLAN

1 A010 Scale: 1/8" = 1'-0"

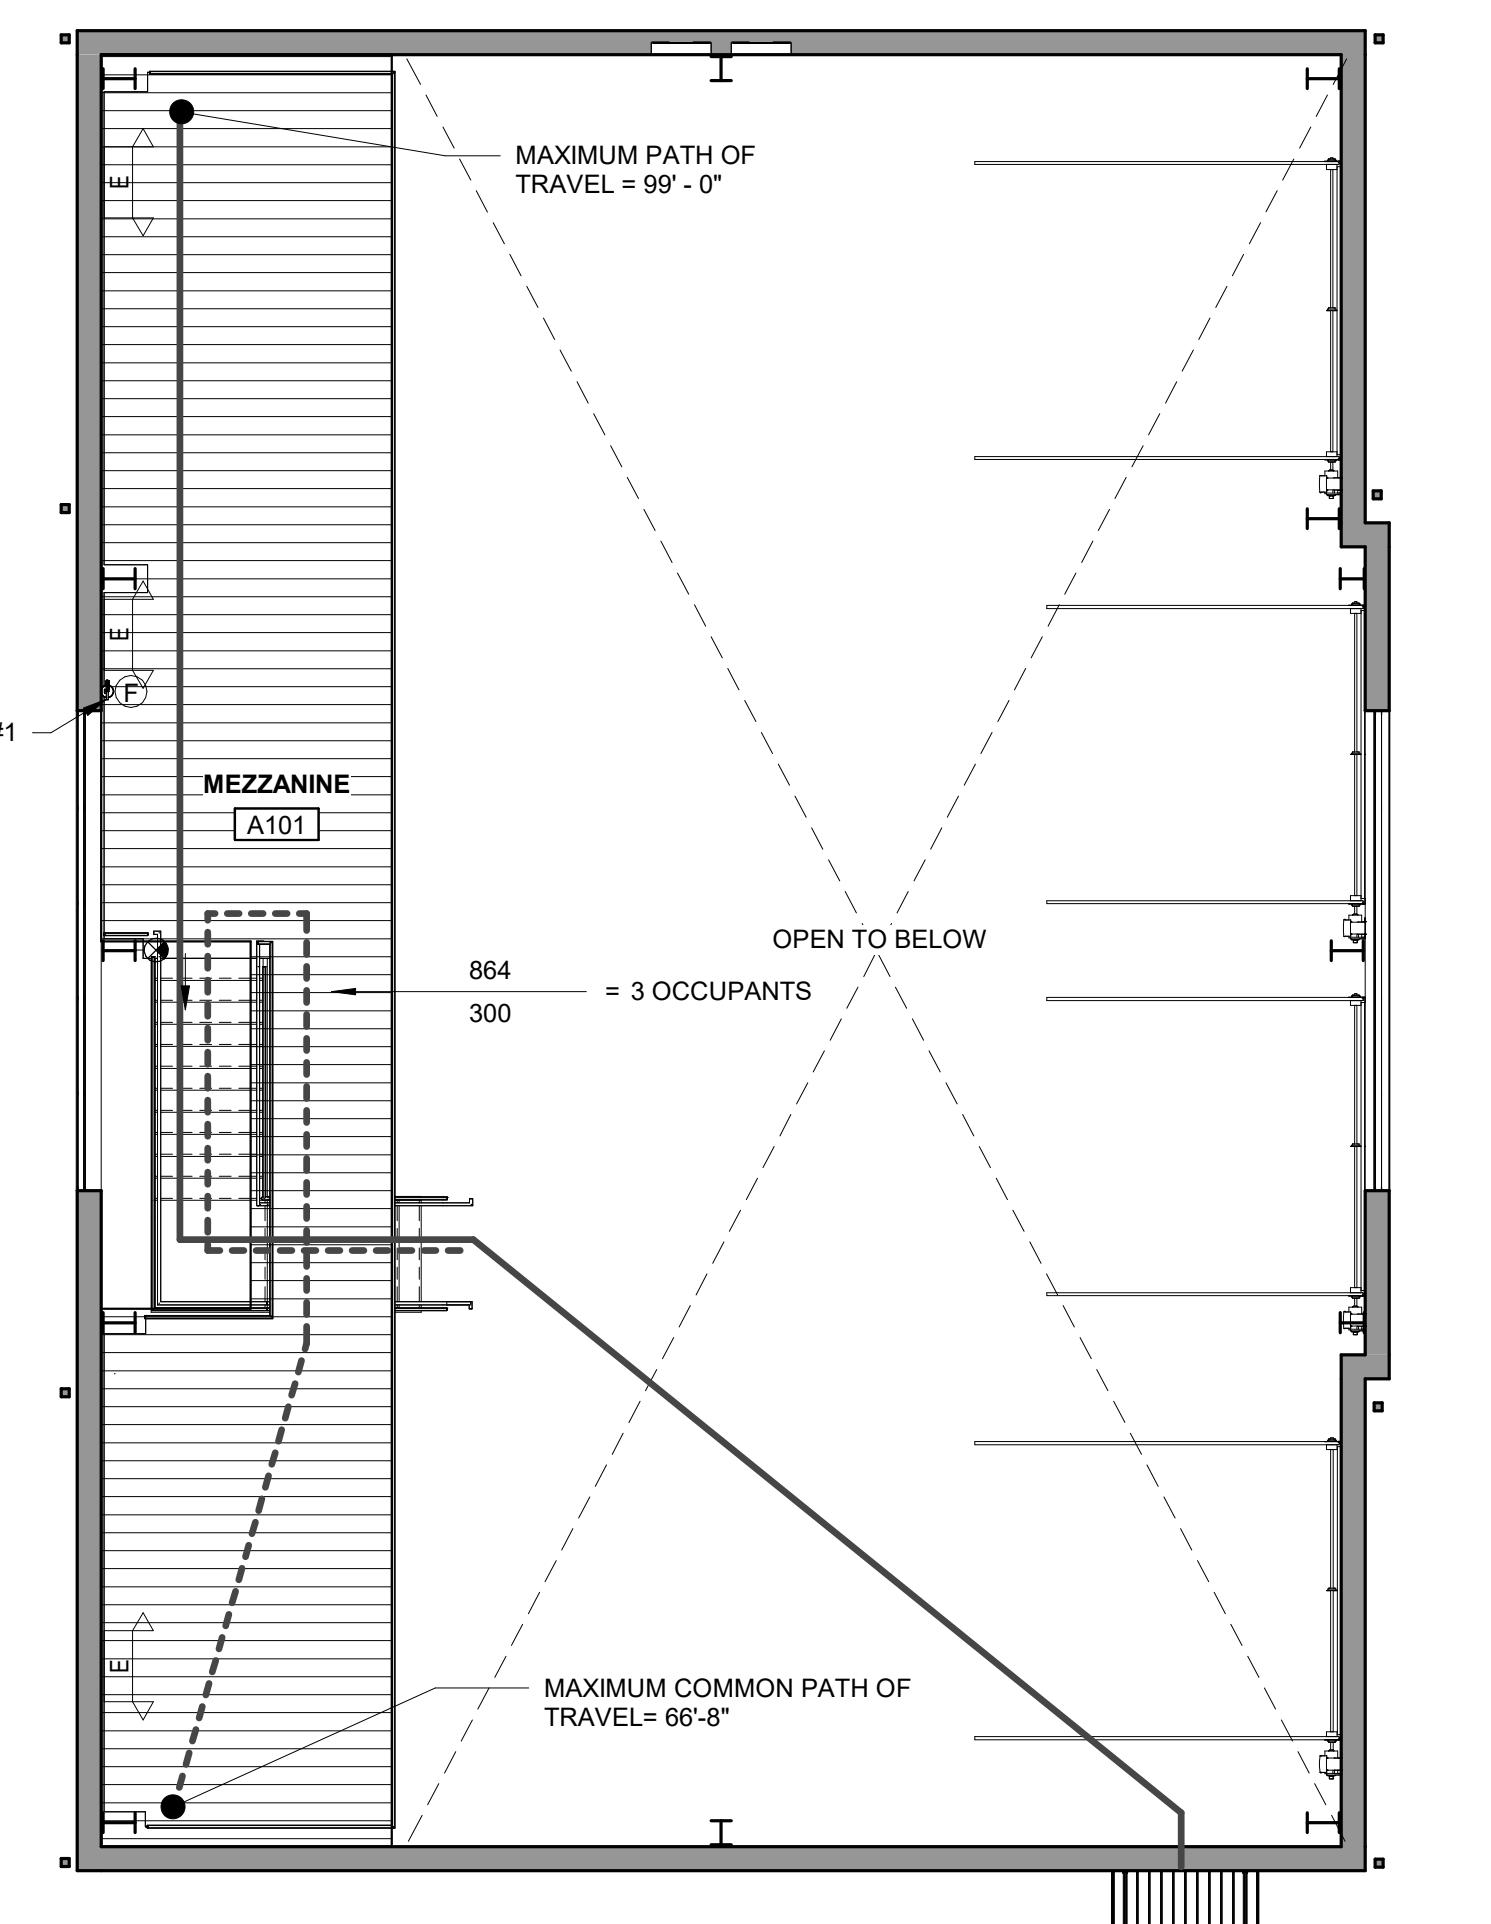

MEZZANINE CODE PLAN

2 A010 Scale: 1/8" = 1'-0"

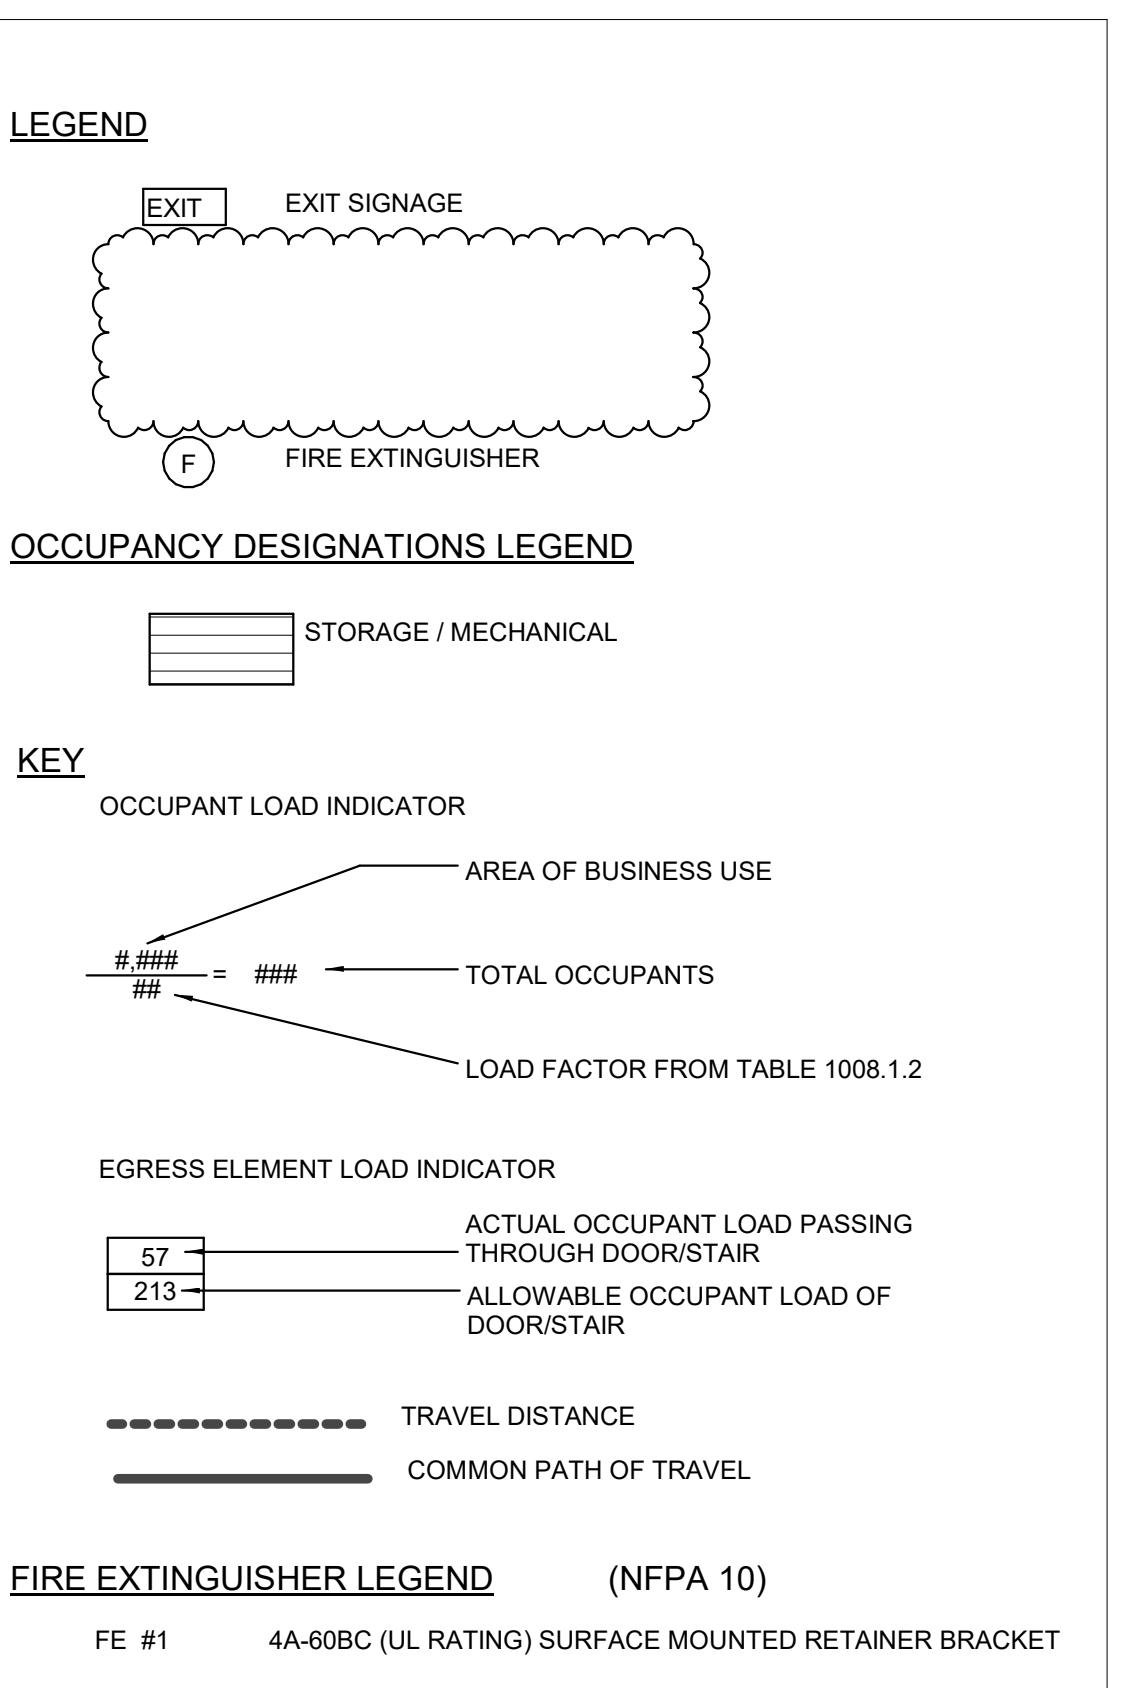

CODE DATA

I. BUILDING & FIRE CODE DATA

MASSACHUSETTS STATE BUILDING CODE 780 CMR MASBC 2017
 2015 INTERNATIONAL BUILDING CODE IBC
 2015 INTERNATIONAL ENERGY CODE IECC
 2015 INTERNATIONAL MECHANICAL CODE IMC
 2015 NATIONAL ELECTRIC CODE NEC
 2015 INTERNATIONAL EXISTING BUILDING CODE IECB
 2017 MASSACHUSETTS SUPPLEMENT 780 CMR dated 2017 10 20
 MA SPECIAL REGULATIONS 780 CMR 110.R1 THROUGH 115.AA dated 2010 10 20
 ARCHITECTURAL ACCESS BOARD 521 CMR dated 2006 01 27
 MA ACCESSIBILITY CODE
 MA STATE PLUMBING CODE 248 CMR dated 2023 12 08
 MA ELECTRICAL CODE 527 CMR 12.00 date 2008
 2022 MASSACHUSETTS FIRE CODE STATE FIRE SAFETY CODE 527 CMR
 NFPA 1 2022 FIRE CODE
 [FIRE PREVENTION REGULATIONS 527 CMR TAKES PRECEDENCE OVER NFPA]
 NFPA REFERENCE STANDARDS FROM MA SBC CHAPTER 35
 NFPA 10 2018 PORTABLE FIRE EXTINGUISHERS
 NFPA 13 2019 INSTALLATION OF SPRINKLERS SYSTEMS
 NFPA 14 2016 INSTALLATION OF STANDPIPE & HOSE SYSTEMS
 NFPA 70 2017 NATIONAL ELECTRICAL CODE
 NFPA 101 2018 NATIONAL FIRE ALARM CODE
 NFPA 101 2018 LIFE SAFETY CODE
 NFPA 241 2022 SAFEGUARDING CONSTRUCTION

Drawn by ADC
 Checked by AHB, JJR
 Revised on # (DATE) (DESCRIPTION)
 2 6/28/2024 Addendum #2

This drawing is copyrighted and is subject to copyright protection as "Technical Work" under Title 17 U. S. C. Sec. 101 et seq. The protection includes but is not limited to the overall form as well as the arrangement and composition of spaces, materials, color and elements in the design. Under Title 17 U. S. C. Sec. 106, it is illegal to reproduce, distribute, or sell a copy of this drawing or buildings being seized and/or monetary compensation being awarded to The Robinson Green Beretta Corporation (RGB). Any reproduction, possession, or use of this drawing or any part thereof without the express written permission of RGB, is prohibited. Violators will be prosecuted to the full extent of the law.

© RGB 2023

Certification

II. BUILDING AREA

TOTAL BUILDING AREA 4,659 S.F.

A. OCCUPANCY & CONSTRUCTION TYPES

BUILDING OCCUPANCY: STORAGE (S-2)
 (OCCUPANCY) (BLDG. AREAS)
 S 3805 S.F.
 S (MEZZANINE) 864 S.F.

CONSTRUCTION TYPE: IIB

THESE CONSTRUCTION TYPES EQUATE TO THE FOLLOWING FIRE RATINGS:

STRUCTURAL ELEMENT	RATING IN HOURS
1. EXTERIOR WALLS	
LOAD BEARING	0
NON-LOAD BEARING	0
2. FIRE WALLS & PARTITION WALLS	0
3. INTERIOR LOAD BEARING WALLS, PARTITIONS, COLUMNS, GIRDERS, TRusses (OTHER THAN ROOF) AND FRAMING	0
4. STRUCTURES SUPPORTING WALL(S)	0
5. FLOOR CONSTRUCTION	0
6. ROOF CONSTRUCTION	0
15' OR LESS TO LOWEST MEMBER	0
GREATER THAN 15' BUT LESS THAN 20' TO LOWEST MEMBER	0
GREATER THAN 20' TO LOWEST MEMBER	0

B. ALLOWABLE AREA AND HEIGHT

1. AREA FOR IIB CONSTRUCTION
 OCCUPANCY S-2 = 26,000SF/FLOOR

2. HEIGHT FOR IIB CONSTRUCTION
 OCCUPANCY S-2 = 3 STORIES/55 FEET ABOVE GRADE
 ACTUAL BUILDING HEIGHT = 1 1/2 STORIES/27 FEET ABOVE GRADE

C. FIRE PROTECTION

1. FIRE ALARM SYSTEM NOT REQUIRED PER NFPA 101 42.3.4.1.1; SUBJECT TO AHJ.

D. EGRESS REQUIREMENTS (W/O SPRINKLER SYSTEM)

1. LENGTH OF TRAVEL
 STORAGE 99'-0" LF
 MAXIMUM LENGTH OF TRAVEL ALLOWED = 300 LF

2. COMMON PATH
 STORAGE 66'-0" LF
 MAXIMUM LENGTH OF COMMON PATH ALLOWED = 75 LF
 DEAD END CORRIDOR 50 LF

3. MEANS OF EGRESS

NUMBER AND WIDTH REQUIRED
 OCCUPANCY LOAD PER FLOOR 500 PEOPLE OR LESS
 TOTAL EXITS REQUIRED = 2 EXITS PER FLOOR

EGRESS WIDTHS REQUIRED
 TOTAL WIDTH REQUIRED FOR STAIRS = 0.3" / person x 3 = 9"
 TOTAL WIDTH REQUIRED FOR DOORS = 0.2" / person x 16 = 3.2"
 WIDTH PROVIDED
 TOTAL WIDTH PROVIDED FOR STAIRS = 58"
 TOTAL WIDTH PROVIDED FOR DOORS = 64"

E. INTERIOR FINISHES

CLASS B OR BETTER FINISHES WILL BE PROVIDED AT EXIT PASSAGEWAYS AND CLASS C OR BETTER IN ROOMS AND ENCLOSED SPACES PER IBC TABLE 803.13 & NFPA 42.3.3

F. SEISMIC CRITERIA

SEE STRUCTURAL DRAWINGS FOR SEISMIC FACTOR REQUIREMENTS

G. STRUCTURAL LOADS

RISK CATEGORY II
 ULTIMATE DESIGN WIND SPEED = 129 MPH
 NOMINAL DESIGN WIND SPEED = 100 MPH
 SNOW LOAD = 40 PSF

H. OCCUPANCY LOADS

1. OCCUPANCY LOAD TYPES CMR 780 TABLE 1004.1.2
 STORAGE 300 SF / PERSON GROSS

2. OCCUPANCY LOAD PER FLOOR
 BY AREA
 FIRST FLOOR 13 OCCUPANTS
 MEZZANINE .3 OCCUPANTS
 BUILDING TOTAL 16 OCCUPANTS

II. PLUMBING FIXTURE ANALYSIS (BASED ON 248 CMR SECTION 10.10 TABLE 1)

III. VARIANCES REQUESTED

REFLIEF FROM PLUMBING FIXTURE REQUIREMENTS = NA

III. MASS STRETCH CODE - 2021

THERMAL ENVELOPE COMPONENT VALUES ALL COMPONENTS TO BE CLEARLY LABELED
 TABLE C301.1 CLIMATE ZONE 5A

METAL BLDGS. EXTERIOR WALLS R-VALUE CONTINUOUS (R 13 + 10) = 23 / Provided R - 28.8
 ROOF R-VALUE CONTINUOUS (R - 19 + 11 LS) = 30 / Provided R - 30

TABLE C402.4 CLIMATE ZONE 5A

FIXED FENESTRATION
 WINDOWS U-FACTOR FRAME TYPE: SINGLE U - .36 / Provided: .34

SWINGING DOOR U-FACTOR DOOR TYPE: SINGLE U - .37 / Provided: .35

OVERHEAD DOOR U-FACTOR DOOR TYPE: SINGLE U - .3 / Provided: .31

GLAZING SHGC DOUBLE GLAZED UNIT: SHGC .38 / Provided: .35


KALWALL PANELS SHGC 4" CRYSTAL 13% SHGC U / Provided: .09

EXPOSED FOUNDATION INSULATION 24" BELOW GRADE = T-CLEAR : 2.125" EXPS AT R-10

50 Holden Street
 Providence, Rhode Island 02908
 Phone: (401) 727-1730
 Fax: (401) 727-1758
 E-mail: rginfo@rgi.net
 www.rgi.net
 Architecture • Project Management • Interior Design

Project
 DEDHAM-WESTWOOD
 WATER DISTRICT

STORAGE
 FACILITY

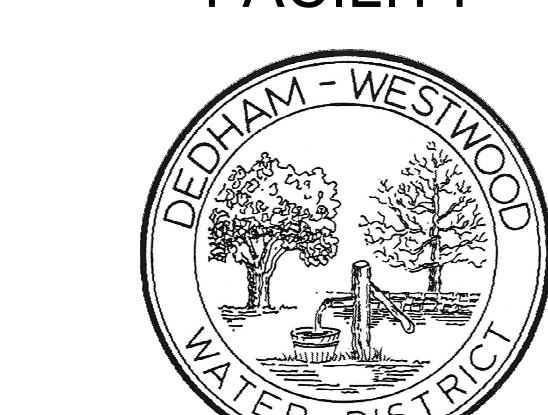

50 ELM STREET
 DEDHAM, MA 02026

Drawing Status
 100% CONSTRUCTION
 DOCUMENTS

Issued On 5/24/2024

Sheet Contents

CODE REVIEW

Project Number: 6790

Drawing No.

A010

Sheet of

GENERAL PLAN NOTES

- COORDINATE ALL WORK w/ CIVIL, STRUCTURAL, PLUMBING, MECHANICAL, ELECTRICAL, & OTHER DRAWINGS. NOTIFY ARCHITECT OF ANY DISCREPANCIES BEFORE PROCEEDING WITH WORK.
- ALL DIMENSIONS TO EXTERIOR CONSTRUCTION ARE TO FACE OF CONCRETE FOUNDATION U.N.O.
- ALL EXTERIOR WALLS ARE TYPE 1A U.N.O.
- ALL DOOR FRAMES SHALL BE A MINIMUM OF 4" CLEAR FROM THE FACE OF ADJACENT WALL TO DOOR JAMB, U.N.O.
- THE FOLLOWING ITEMS ARE DESIGNATED AS FOLLOWS:
FE FIRE EXTINGUISHER WITH SURFACE MOUNTED RETAINER BRACKET
- REFER TO ENLARGED FLOOR PLANS FOR ADDITIONAL INFORMATION.
- REFER TO DRAWING G001 FOR ABBREVIATIONS AND SYMBOLS DESCRIPTION.

CONSTRUCTION LEGEND

	NEW WALL ITEM
	DOWNSPOUT
	FURNISH AND INSTALL
	WORK NOTES WITHOUT AN ARROW INDICATE AN ENTIRE SPACE/AREA.
	WORK NOTES WITH AN ARROW(S) INDICATE SPECIFIC AREAS &or ITEMS.

Drawn by	ADC
Checked by	AHB, JJR
Revised on	
#	(DATE) (DESCRIPTION)
1	6/25/2024 Addendum #1
2	6/28/2024 Addendum #2

PLAN WORK NOTES

- CONCRETE SIDEWALK W/ TOOLED EDGES AND BROOM FINISH. SLOP AWAY FROM BUILDING FOUNDATION (2% MAX SLOPE). RE: CIVIL DWGS.
- F&I CONTROL JOINT SPACED 5'-0" O.C.
- F&I 8" DIAMETER 42" HIGH STEEL BOLLARD FILLED WITH CONCRETE AND PAINTED. RE: 7/A501
- F&I 3-5/8" METAL STUD AND 1/4" MARINE GRADE FRT PLYWOOD, FIELD PAINTED WHITE; RE: 1/A500
- NEW METAL STAIR ASSEMBLY, RE: ENLARGED DETAILS AND COORDINATE w/ STRUCTURAL DRAWINGS, TYP.
- METAL GUARDRAIL, RE: ENLARGED DETAILS AND COORDINATE w/ STRUCTURAL DRAWINGS, TYP.
- NEW TRENCH DRAIN AT EACH OVERHEAD DOOR; RE: PLUMBING DWGS.
- NEW ELECTRICAL PANEL, MAINTAIN ANY REQ. FRONT CLEARANCES, RE: ELECTRICAL DWGS.
- NEW GAS DETECTION AND FAN CONTROL PANELS, RE: MECHANICAL AND ELECTRICAL DWGS.
- NEW PREFAB ALUMINUM CANOPY, RE: 2/A501
- NEW OVERHEAD SECTIONAL DOOR WITH PUSHBUTTON; RE: ELECTRICAL DWGS.
- EXTERIOR HOSE BIBB, RE: PLUMBING DWGS.
- TRAP DRILL BOX, RE: PLUMBING AND ELECTRICAL DWGS.
- GAS METER, COORDINATE FINAL LOCATION WITH LOCAL UTILITY COMPANY AND OWNER, RE: PLUMBING DWGS.
- FIRE EXTINGUISHER WITH SURFACE MOUNTED RETAINER BRACKET; RE: 2/A502.

50 Holden Street
Providence, Rhode Island 02908
Phone: (401) 272-1730
Fax: (401) 273-7156
E-mail: rgbc@rgbc.net
www.rgbc.net

Architecture • Project Management • Interior Design

Project

DEDHAM-WESTWOOD
WATER DISTRICT

STORAGE
FACILITY



50 ELM STREET
DEDHAM, MA 02026

Drawing Status
100% CONSTRUCTION
DOCUMENTS



Issued On 5/24/2024

Sheet Contents
FLOOR PLANS

Project Number. 6790

Drawing No. A100

Sheet of 1

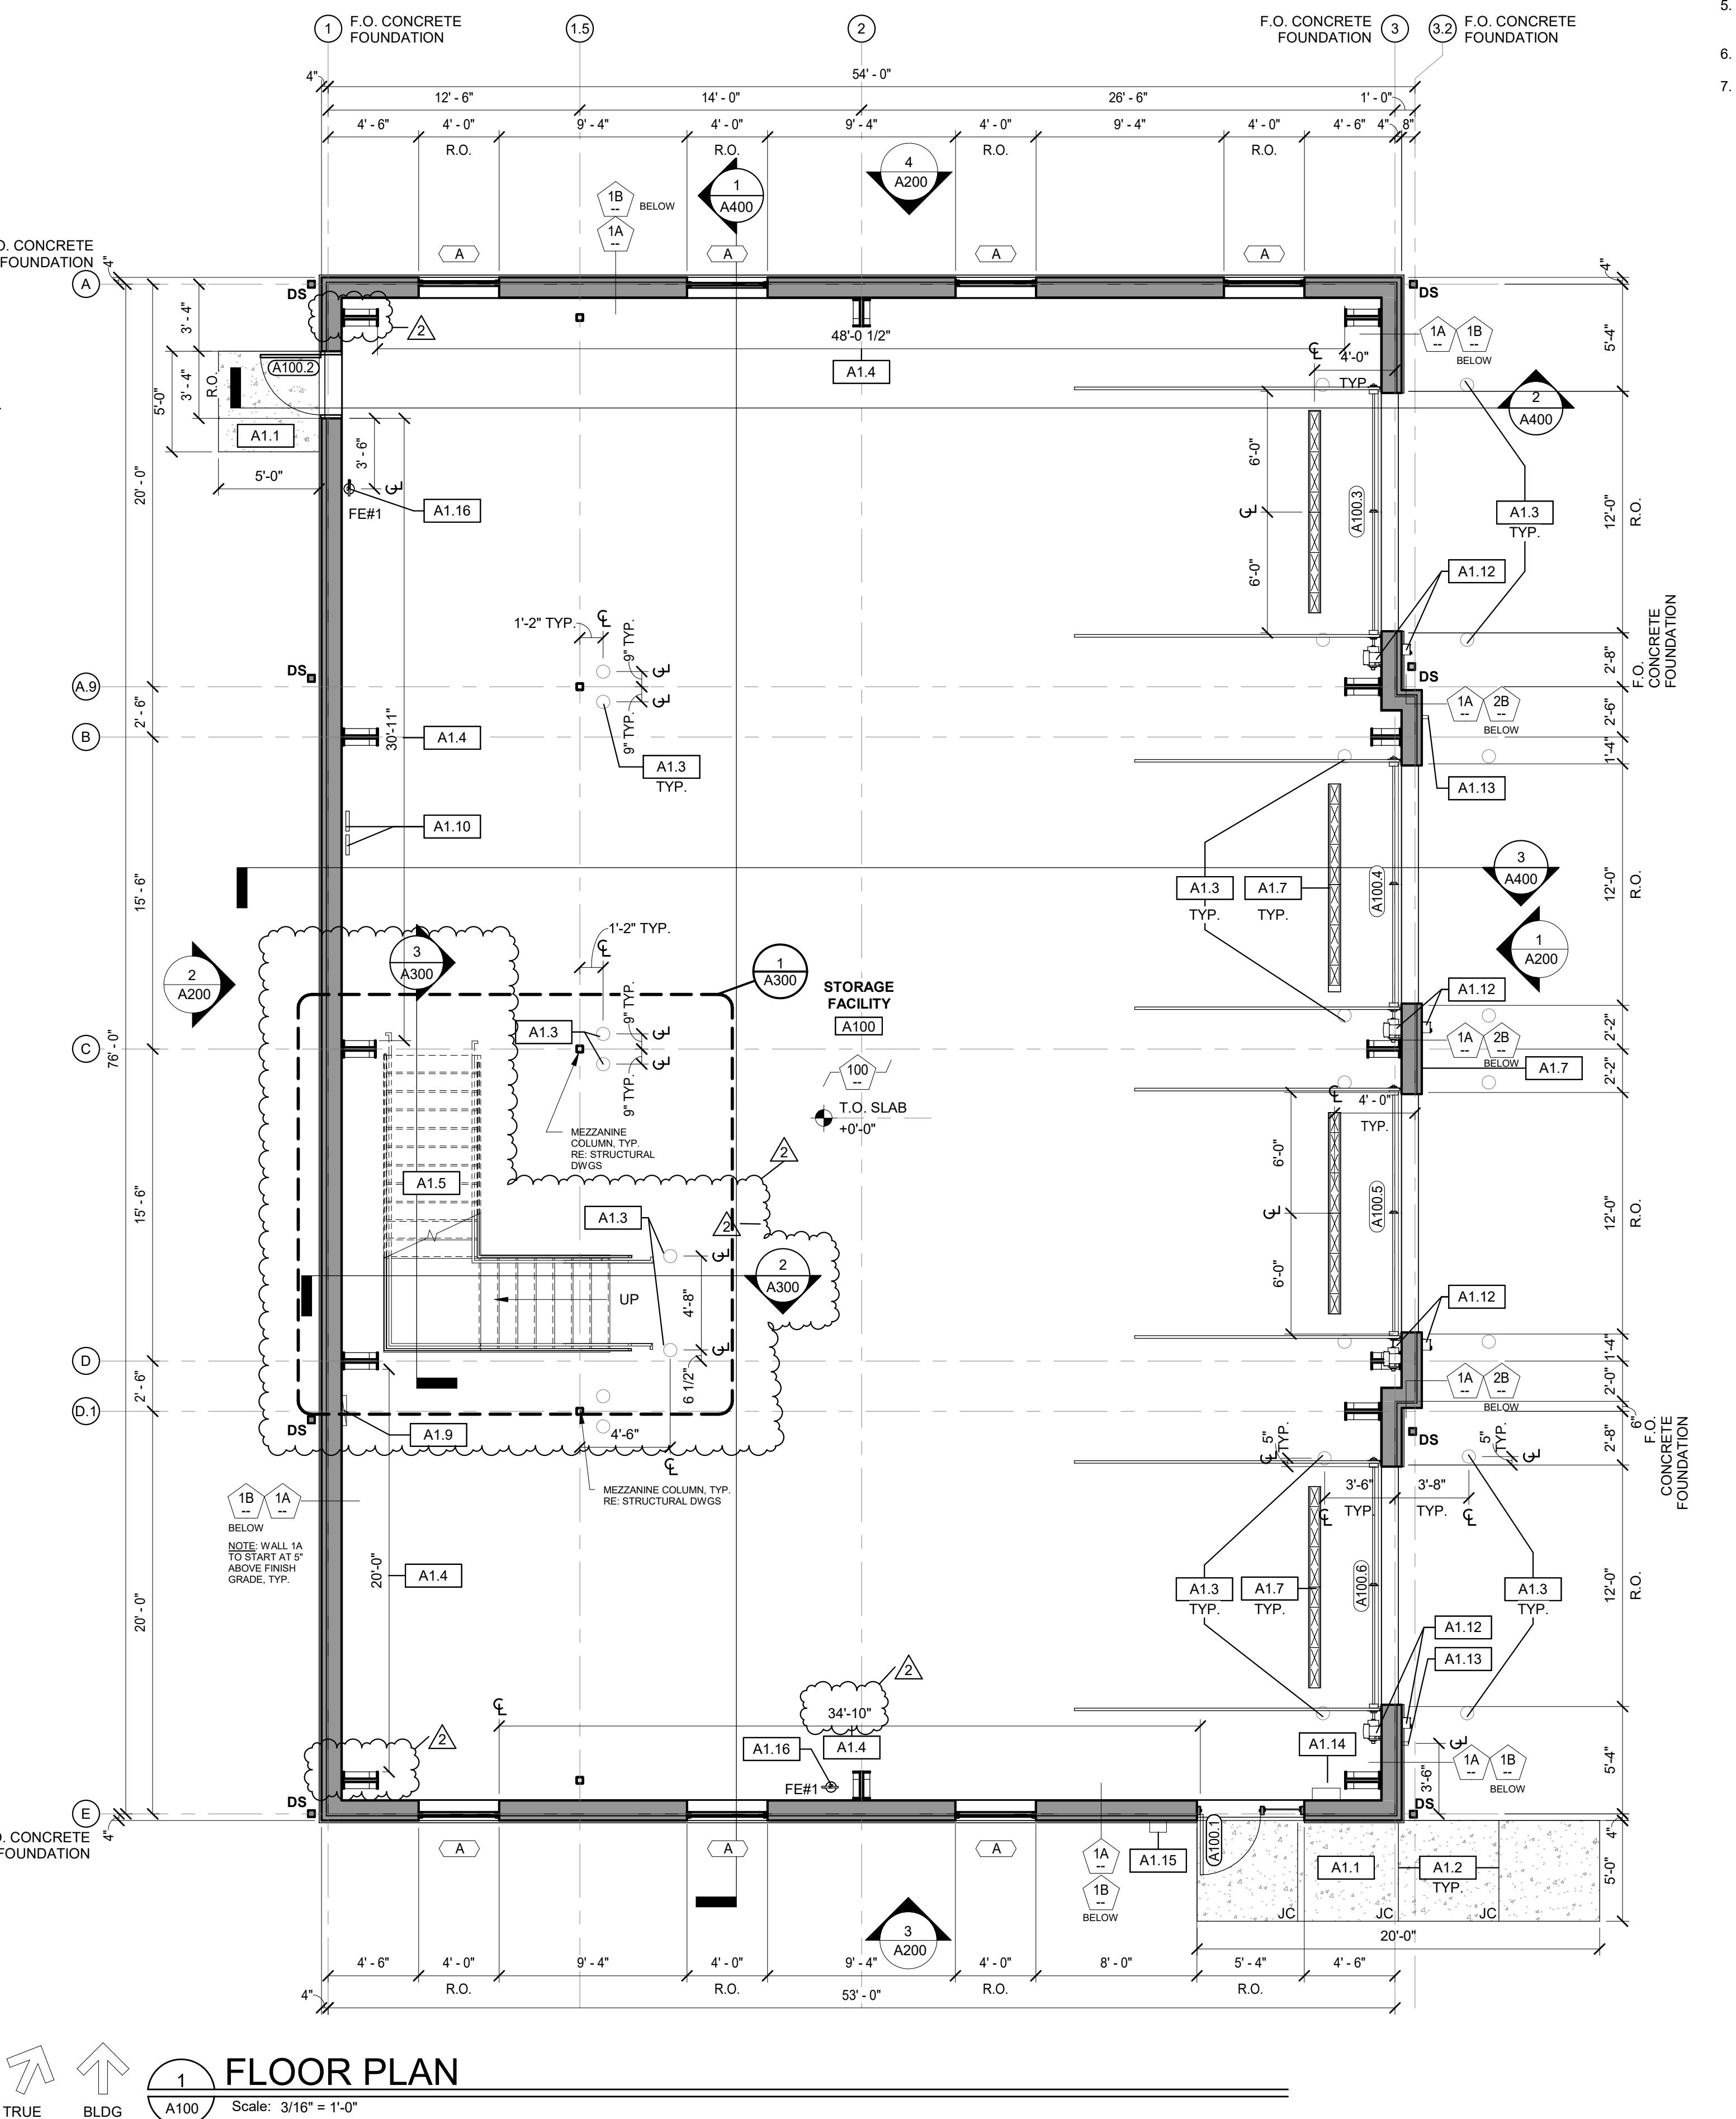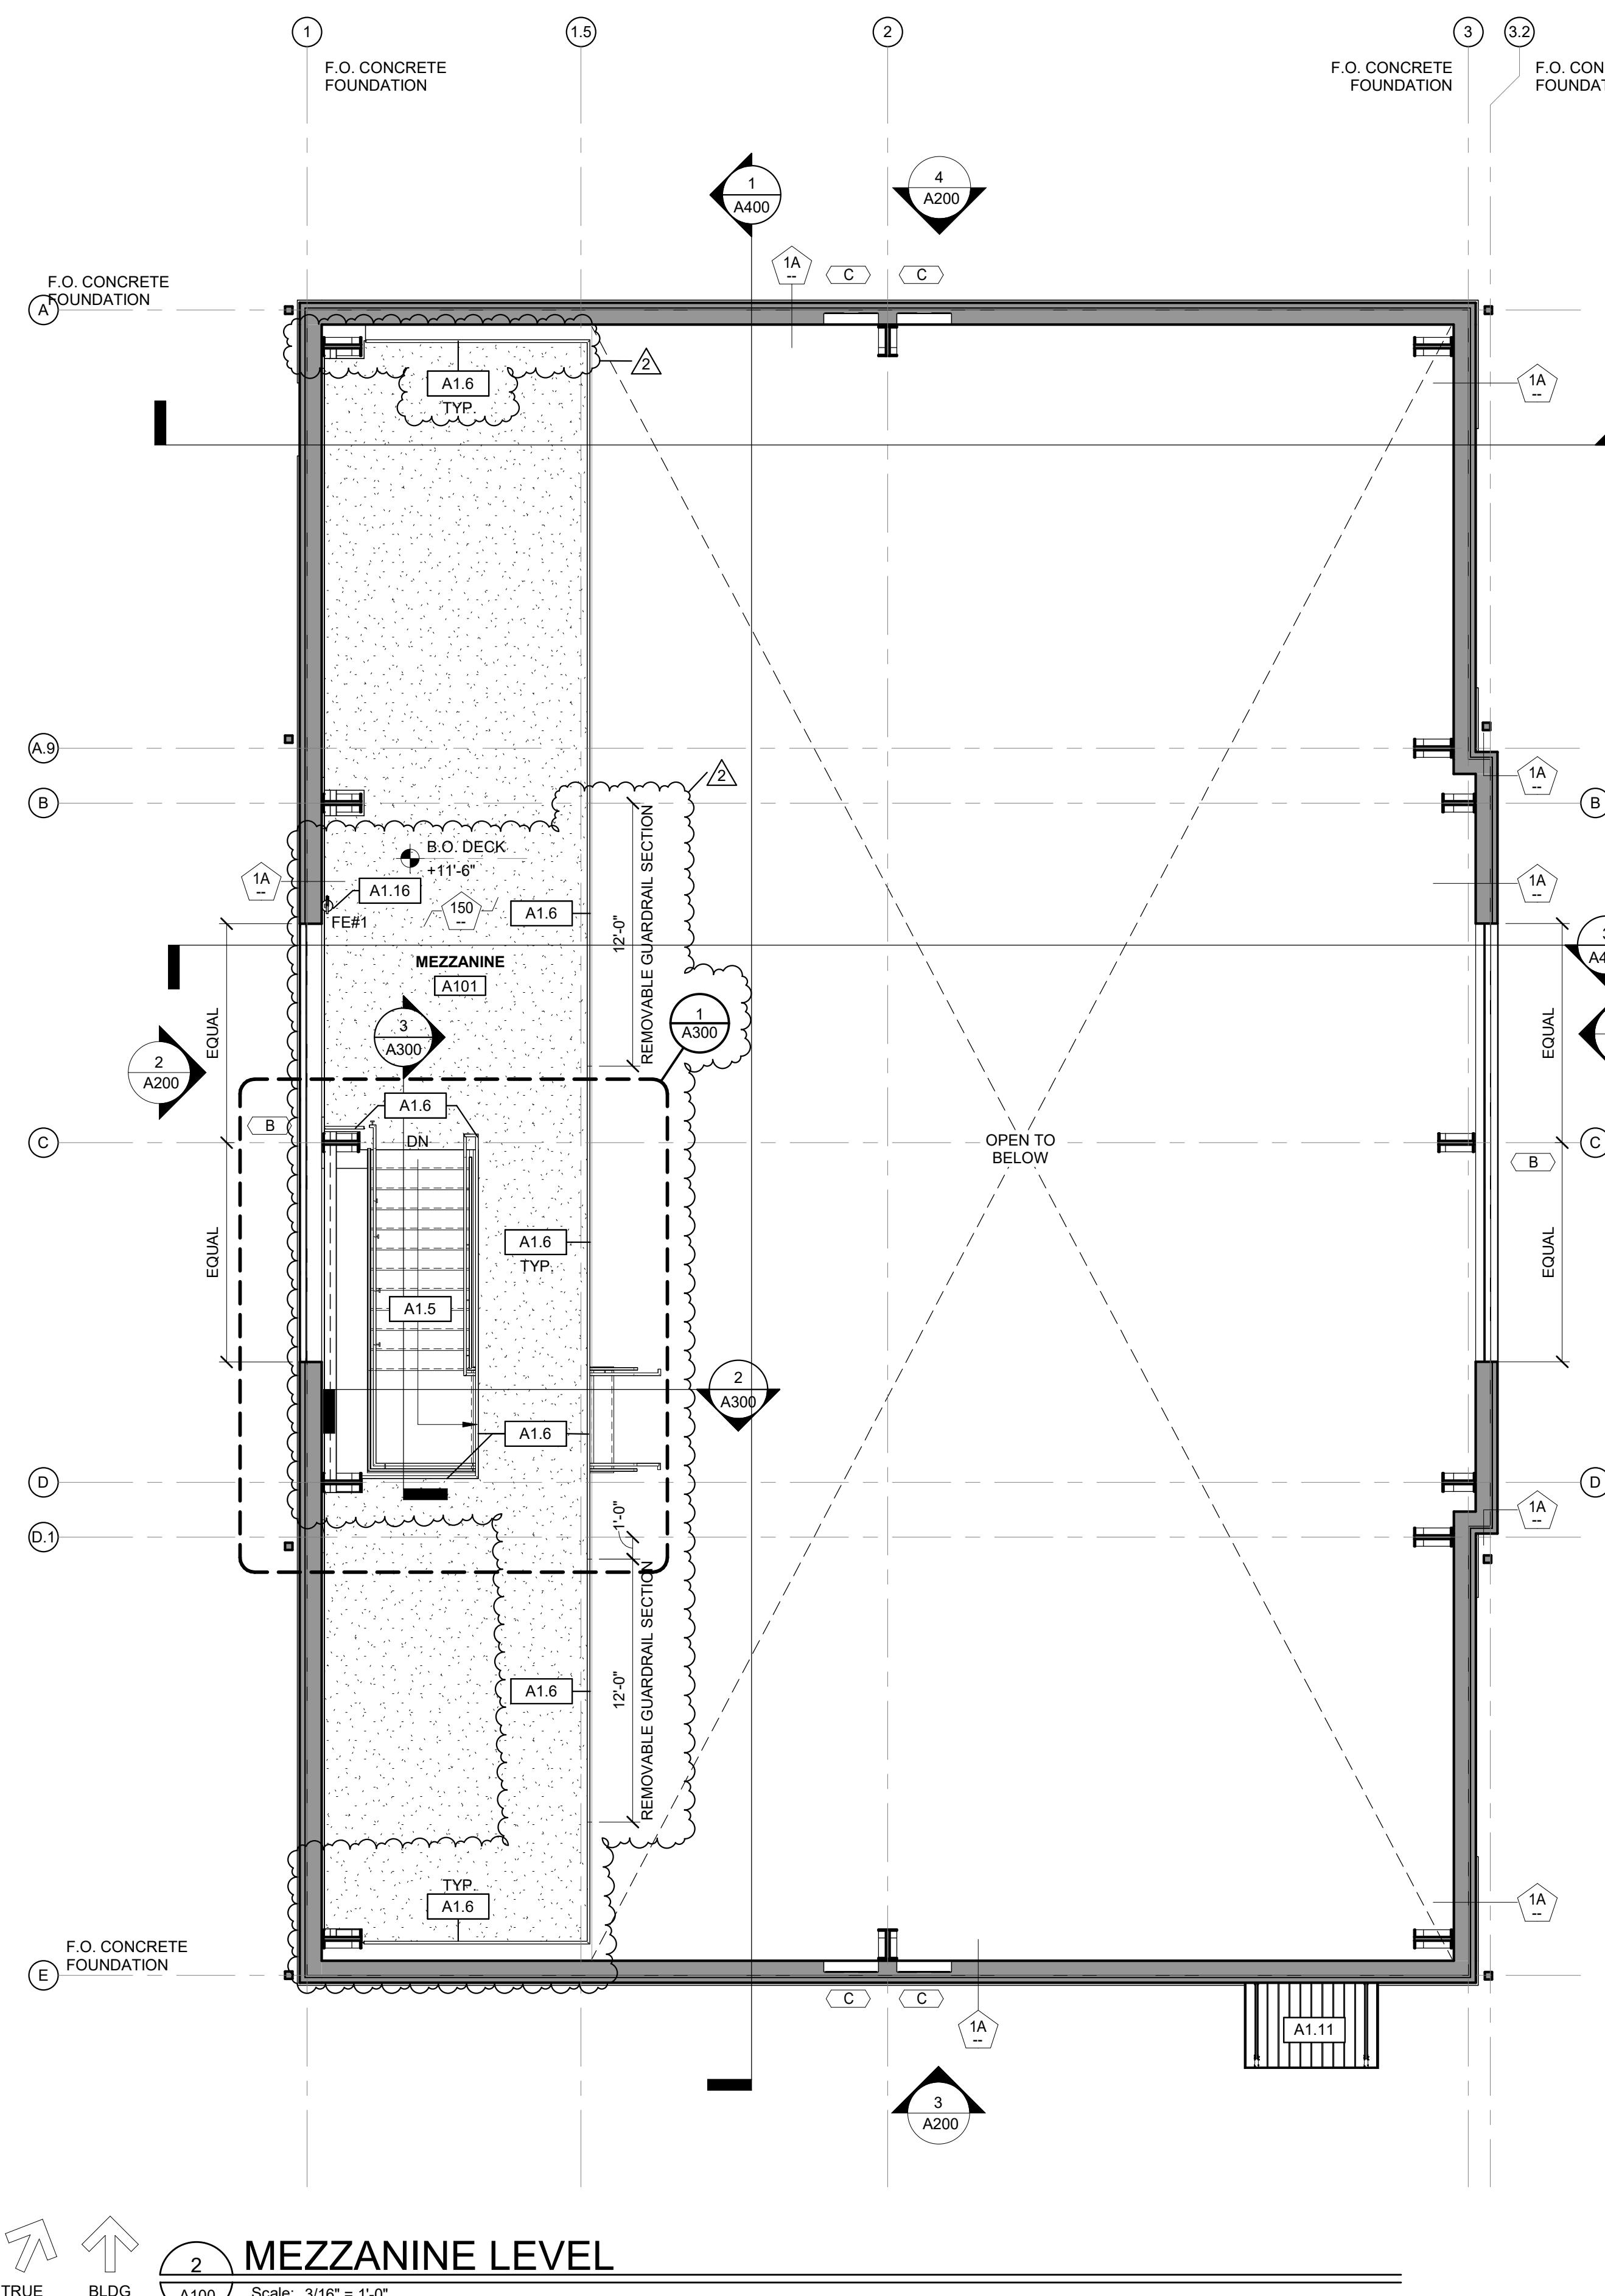

PLAN WORK NOTES

- CONCRETE SIDEWALK W/ TOOLED EDGES AND BROOM FINISH. SLOP AWAY FROM BUILDING FOUNDATION (2% MAX SLOPE). RE: CIVIL DWGS.
- F&I CONTROL JOINT SPACED 5'-0" O.C.
- F&I 8" DIAMETER 42" HIGH STEEL BOLLARD FILLED WITH CONCRETE AND PAINTED. RE: 7/A501
- F&I 3-5/8" METAL STUD AND 1/4" MARINE GRADE FRT PLYWOOD, FIELD PAINTED WHITE; RE: 1/A500
- NEW METAL STAIR ASSEMBLY, RE: ENLARGED DETAILS AND COORDINATE w/ STRUCTURAL DRAWINGS, TYP.
- METAL GUARDRAIL, RE: ENLARGED DETAILS AND COORDINATE w/ STRUCTURAL DRAWINGS, TYP.
- NEW TRENCH DRAIN AT EACH OVERHEAD DOOR; RE: PLUMBING DWGS.
- NEW ELECTRICAL PANEL, MAINTAIN ANY REQ. FRONT CLEARANCES, RE: ELECTRICAL DWGS.
- NEW GAS DETECTION AND FAN CONTROL PANELS, RE: MECHANICAL AND ELECTRICAL DWGS.
- NEW PREFAB ALUMINUM CANOPY, RE: 2/A501
- NEW OVERHEAD SECTIONAL DOOR WITH PUSHBUTTON; RE: ELECTRICAL DWGS.
- EXTERIOR HOSE BIBB, RE: PLUMBING DWGS.
- TRAP DRILL BOX, RE: PLUMBING AND ELECTRICAL DWGS.
- GAS METER, COORDINATE FINAL LOCATION WITH LOCAL UTILITY COMPANY AND OWNER, RE: PLUMBING DWGS.
- FIRE EXTINGUISHER WITH SURFACE MOUNTED RETAINER BRACKET; RE: 2/A502.

Project Number. 6790

Drawing No. A100

Sheet of 1

REFLECTED CEILING PLAN NOTES

- NOT ALL CEILING MOUNTED &/OR SUSPENDED ITEMS, COMPONENTS, &/OR WORK MAY BE SHOWN. CONTRACTOR TO COORDINATE w/ ALL DRAWINGS INCLUDING STRUCTURAL, PLUMBING, MECHANICAL, AND ELECTRICAL DRAWINGS. NOTIFY THE ARCHITECT OF ANY ADDITIONAL ITEMS &/OR DISCREPANCIES BEFORE STARTING WORK.
- ALL CEILING MOUNTED ITEMS ARE TO BE CENTERED IN CEILING TILES U.N.O.
- SPRINKLER HEAD LAYOUT IS APPROXIMATE AND NOT ALL HEADS MAY BE SHOWN. COORDINATE w/ SPRINKLER DRAWINGS AND NOTIFY ARCHITECT OF ANY DISCREPANCIES BEFORE STARTING WORK.
- PROVIDE WHITE GROMMET TRIM AT ALL SUPPORT CABLE &/OR WIRING PENETRATIONS FOR SUSPENDED ELEMENTS.

CONSTRUCTION LEGEND

	NEW WALL/ITEM
F&I	FURNISH AND INSTALL
#	WORK NOTES WITHOUT AN ARROW INDICATE AN ENTIRE SPACE/AREA.
→ #	WORK NOTES WITH AN ARROW(S) INDICATE SPECIFIC AREAS &/OR ITEMS.
SAT	CEILING FINISH
9'-0"	HEIGHT OF CEILING ABOVE FINISH FLOOR

Drawn by ADC, ML
Checked by AHB, JJR
Revised on # (DATE) (DESCRIPTION)
1 6/25/2024 Addendum #1
2 6/28/2024 Addendum #2

REFLECTED CEILING PLAN LEGEND

	LINEAR LED LIGHT FIXTURE COORDINATE W/ ELEC. DWGS
	HIGH BAY SUSPENDED LED LIGHT FIXTURE COORDINATE W/ ELEC. DWGS
	EXTERIOR LED SURFACE MOUNTED UP/DOWN LIGHT FIXTURE; RE: ELECTRICAL DRAWINGS
	EXTERIOR GOOSENECK STYLE LED LIGHT FIXTURE; RE: ELECTRICAL DRAWINGS
	EXTERIOR DOWNLIGHT LED LIGHT FIXTURE; RE: ELECTRICAL DRAWINGS
	EXIT SIGN COORDINATE W/ ELEC. DWGS
	WALL MOUNTED DIRECTIONAL EXIT SIGN COORDINATE W/ ELEC. DWGS
	EMERGENCY BATTERY BACKUP EGGSIT LIGHTING COORDINATE W/ ELEC. DWGS
	EXTERIOR (WET LOCATION) REMOTE DOUBLE HEAD LED LIGHT FIXTURE; COORDINATE W/ ELEC. DWGS
	CEILING FAN COORDINATE W/ MECH. DWGS
	GAS FIRED INFRARED HEATER RE: MECHANICAL & ELECTRICAL DWGS
	PREFABRICATED METAL CANOPY
	DUCT; RE: MECHANICAL DWGS
	DOWNSPOUT
	CO2 SENSOR COORDINATE W/ MECH. DWGS
	OCCUPANCY SENSOR COORDINATE W/ ELEC. DWGS
	HEAT DETECTOR COORDINATE W/ ELEC. DWGS

RCP WORK NOTES


RCP1 F&I MECHANICAL DUCT, EXHAUST FANS AND MOTORIZED DAMPERS RE: ELECTRICAL & MECHANICAL DRAWINGS
RCP2 F&I STORM-PROOF LOUVER WITH INSERT AND BIRD SCREEN
RCP3 F&I GAS FIRED INFRARED HEATER RE: PLUMBING, ELECTRICAL, & MECHANICAL DRAWINGS

50 Holden Street
Providence, Rhode Island 02908
Phone: (401) 272-1730
Fax: (401) 273-1756
E-mail: rginfo@rgi.net
www.rg.net


Architecture • Project Management • Interior Design

Project

DEDHAM-WESTWOOD
WATER DISTRICT

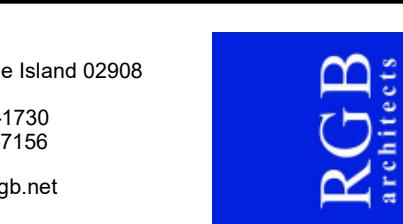

STORAGE
FACILITY

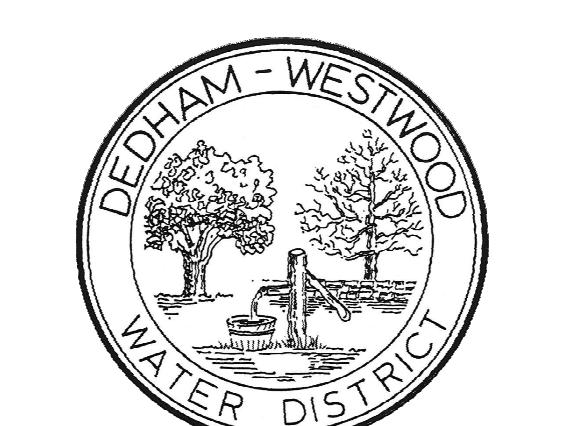

50 ELM STREET
DEDHAM, MA 02026

Drawing Status
100% CONSTRUCTION
DOCUMENTS

Issued On 5/24/2024



Sheet Contents

REFLECTED CEILING
PLAN

Project Number. 6790

Drawing No. A600

Sheet of

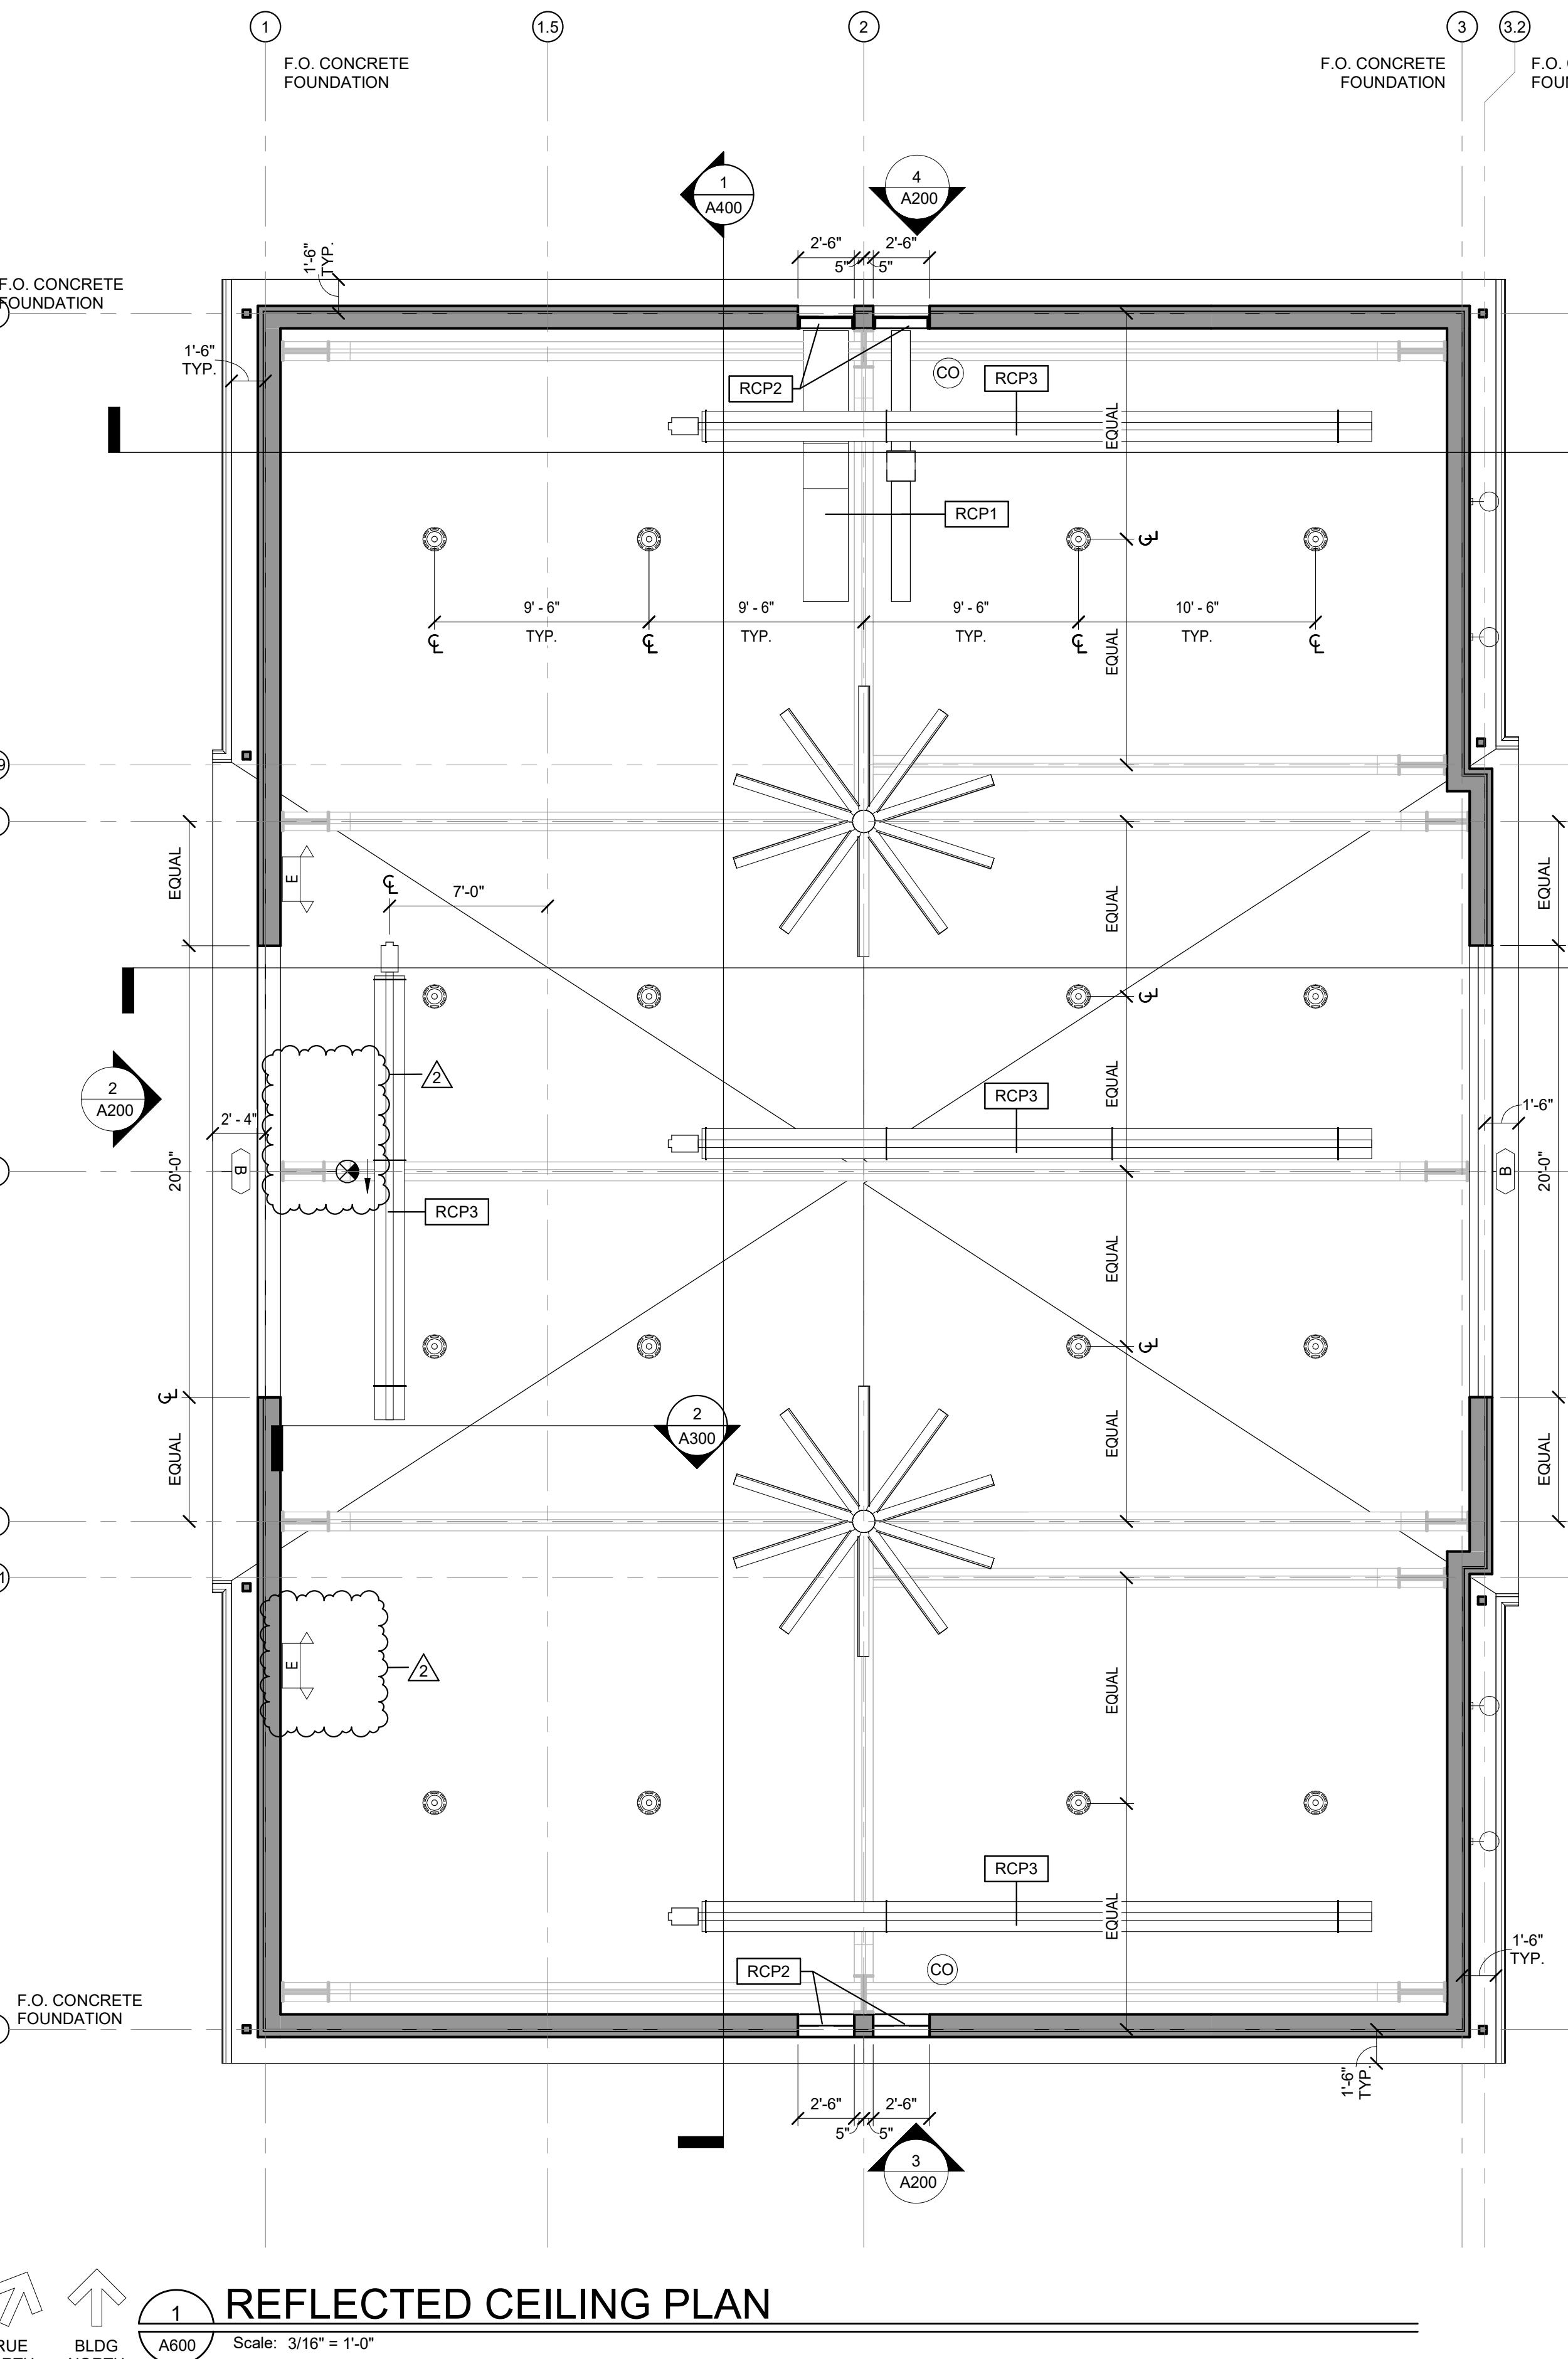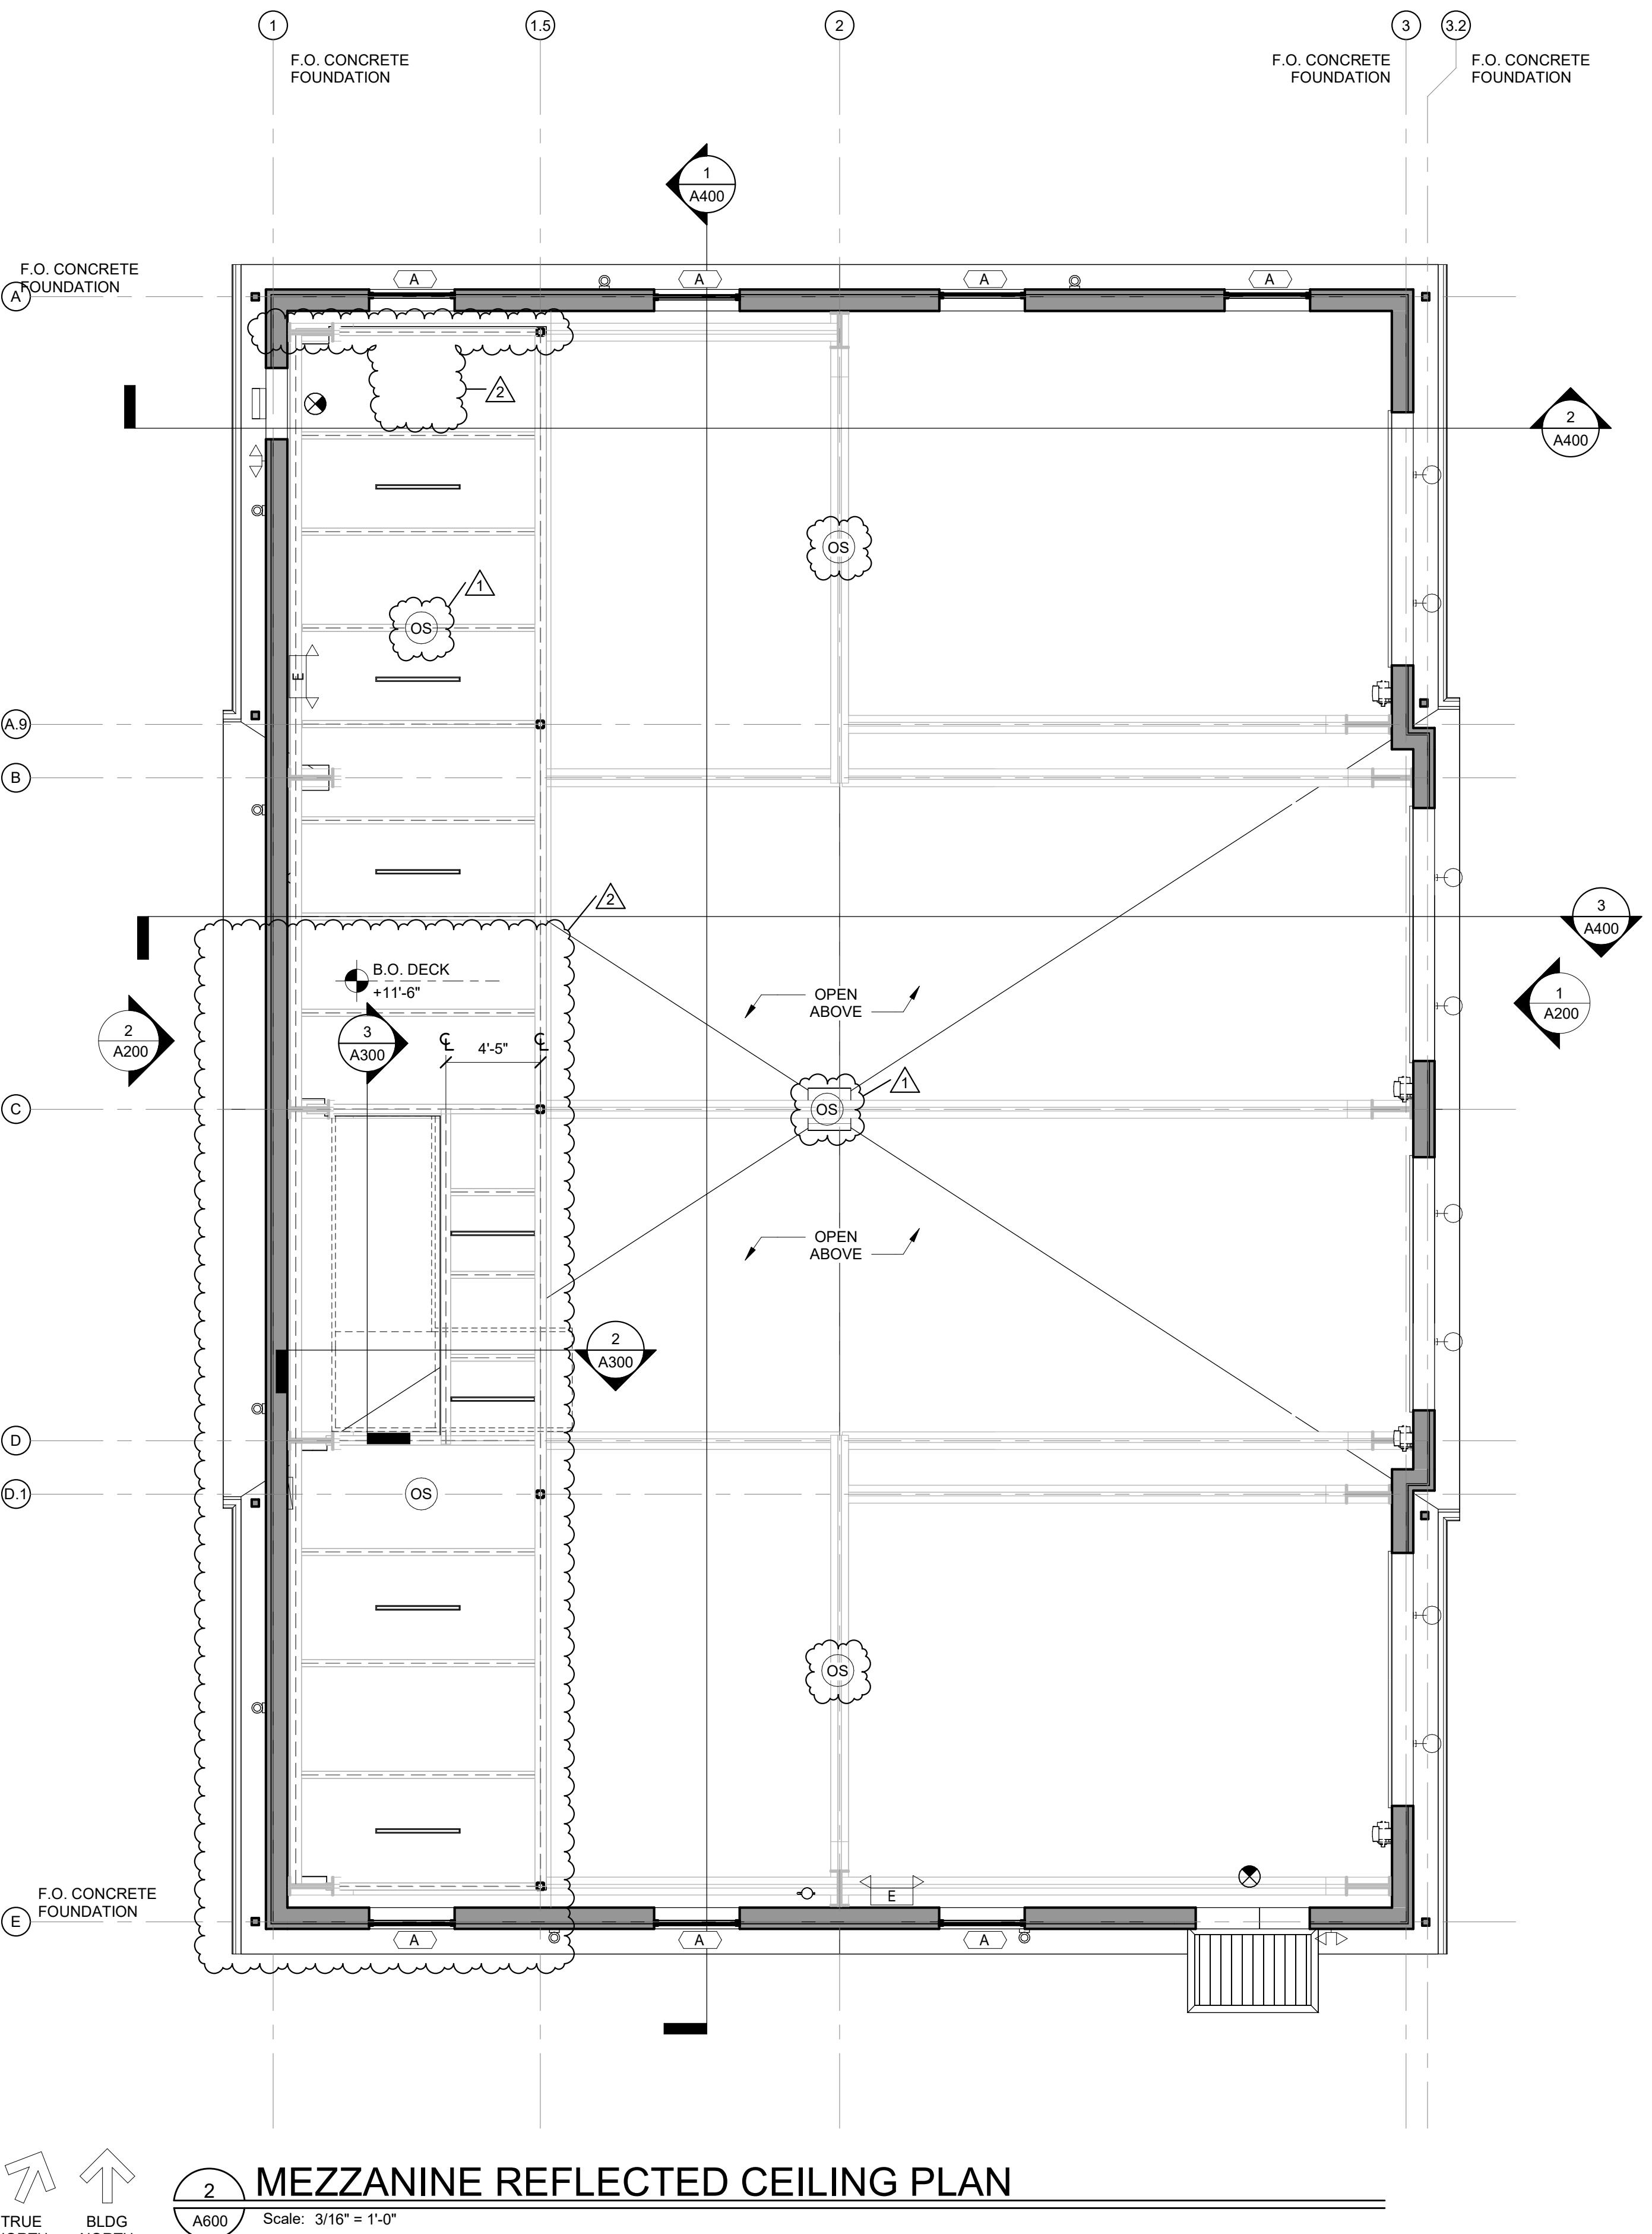

REFLECTED CEILING PLAN

Sheet of

2 ENLARGED ELECTRIC ROOM PLAN

ES100 / Scale: 1/4" = 1'-0"

GENERAL NOTES:

1. THE ELECTRICAL SUB-CONTRACTOR SHALL BE RESPONSIBLE FOR PROVIDING ALL NECESSARY CONDUIT, RACEWAYS AND PULL BOXES AS WELL AS CIRCUIT FUSING FOR THE GATE OPERATORS IN ACCORDANCE WITH THE MANUFACTURER'S INSTALLATION INSTRUCTIONS.

2. CONDUIT ROUTING SHOWN IS DIAGRAMMATIC ONLY. EXACT INSTALLATION LOCATION AND ROUTING OF CONDUITS SHALL BE DETERMINED IN THE FIELD WITH EXISTING AND PROPOSED SITE UTILITIES.

KEYED NOTES:

① PROVIDE (1) 3/4" C WITH BRANCH CIRCUIT WIRING FOR GATE OPERATOR. CONDUIT SHALL BE ROUTED THROUGH ATTIC SPACE, AND SHALL BE RUN EXPOSED ON THE EXTERIOR OF THE BUILDING. PROVIDE WEATHERPROOF JUNCTION BOX WHERE CONDUIT PENETRATES BUILDING EXTERIOR AND TRANSITION TO 3/4" SCHEDULE 40 PVC CONDUIT. RUN BELOW GRADE TO GATE OPERATOR. EXACT CONDUIT ROUTING SHALL BE DETERMINED IN THE FIELD. REFER TO ELECTRICAL RISER DIAGRAM ON DRAWING E300 FOR ADDITIONAL INFORMATION.

② PROVIDE NEW 20A/1P CIRCUIT BREAKER IN EXISTING AVAILABLE SPACE TO SERVE GATE OPERATOR. EXISTING PANEL IS MANUFACTURED BY NEW CIRCUIT BREAKER SHALL BE COORDINATED WITH THE EXISTING EQUIPMENT. MATCH THE EXISTING AIC RATING. REFER TO RISER DIAGRAM KEYED NOTE #5 ON DRAWING E300 FOR ADDITIONAL INFORMATION.

③ CONDUIT FOR FEEDER TO STORAGE BUILDING PANELBOARD SHALL BE ROUTED THROUGH ATTIC SPACE, AND SHALL BE RUN EXPOSED ON THE EXTERIOR OF THE BUILDING. PROVIDE WEATHERPROOF JUNCTION BOX WHERE CONDUIT PENETRATES BUILDING EXTERIOR AND TRANSITION TO SCHEDULE 40 PVC CONDUIT. RUN BELOW GRADE TO PANELBOARD "P1". EXACT CONDUIT ROUTING SHALL BE DETERMINED IN THE FIELD. REFER TO ELECTRICAL RISER DIAGRAM ON DRAWING E300 FOR ADDITIONAL INFORMATION.

④ PROVIDE (1) 3/4" C WITH PULLSTRING FROM STORAGE ROOM TO GATE-ARMED CARD READER CONDUIT SHALL BE ROUTED THROUGH ATTIC SPACE, AND SHALL BE RUN EXPOSED ON THE EXTERIOR OF THE BUILDING. PROVIDE WEATHERPROOF JUNCTION BOX WHERE CONDUIT PENETRATES BUILDING EXTERIOR AND TRANSITION TO 2" SCHEDULE 40 PVC CONDUIT. RUN BELOW GRADE TO STORAGE BUILDING AND STUB UP 12' AFT ADJACENT TO PANELBOARD "P1". EXACT CONDUIT ROUTING SHALL BE DETERMINED IN THE FIELD. CONDUIT SHALL BE RUN IN TRENCH WITH PANELBOARD "P1" FEEDER CONDUIT. MAINTAIN ALL REQUIRED SEPARATION DISTANCES BETWEEN CONDUITS.

⑤ PROVIDE SURGE PROTECTIVE DEVICE FOR GATE OPERATOR BRANCH CIRCUIT EQUAL TO DITEK #DTK-120SLR.

⑥ PROVIDE (1) 3/4" SCHEDULE 40 PVC CONDUIT WITH PULL STRING FROM GATE OPERATOR TO CARD READER LOCATION. COORDINATE EXACT LOCATION WITH CIVIL DRAWINGS.

⑦ PROVIDE (1) 3/4" SCHEDULE 40 PVC CONDUIT WITH PULL STRING FROM GATE OPERATOR TO LOOP DETECTOR. PROVIDE WEATHERPROOF/WATERPROOF IN-GRADE JUNCTION BOX FOR SPLICING OF CABLES. COORDINATE EXACT LOCATION WITH CIVIL DRAWINGS.

⑧ PROVIDE (1) 2" C WITH PULLSTRING FROM TEL/DATA EQUIPMENT LOCATION MAIN ELECTRIC ROOM TO NEW STORAGE BUILDING. LABEL EACH END OF THE CONDUIT WITH THE ORIGIN AND TERMINATION POINTS. CONDUIT SHALL BE ROUTED THROUGH ATTIC SPACE, AND SHALL BE RUN EXPOSED ON THE EXTERIOR OF THE BUILDING. PROVIDE WEATHERPROOF JUNCTION BOX WHERE CONDUIT PENETRATES BUILDING EXTERIOR AND TRANSITION TO 2" SCHEDULE 40 PVC CONDUIT. RUN BELOW GRADE TO STORAGE BUILDING AND STUB UP 12' AFT ADJACENT TO PANELBOARD "P1". EXACT CONDUIT ROUTING SHALL BE DETERMINED IN THE FIELD. CONDUIT SHALL BE RUN IN TRENCH WITH PANELBOARD "P1" FEEDER CONDUIT. MAINTAIN ALL REQUIRED SEPARATION DISTANCES BETWEEN CONDUITS.



1 ELECTRICAL SITE PLAN


ES100 / Scale: 1" = 20'-0"



50 Holden Street
Providence, Rhode Island 02908
Phone: (401) 272-1730
Fax: (401) 273-1750
E-mail: rgbs@rgbs.net
www.rgbs.net
Architecture • Project Management • Interior Design
Project

DEDHAM-WESTWOOD WATER DISTRICT

STORAGE FACILITY

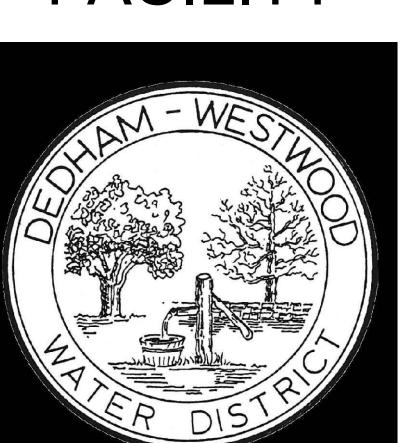

50 ELM STREET
DEDHAM, MA 02026

Drawing Status
100% CONSTRUCTION DOCUMENTS

Issued On 5/24/2024


Sheet Contents

ELECTRICAL SITE PLAN

Project Number. 6790

Drawing No. ES100

Sheet of

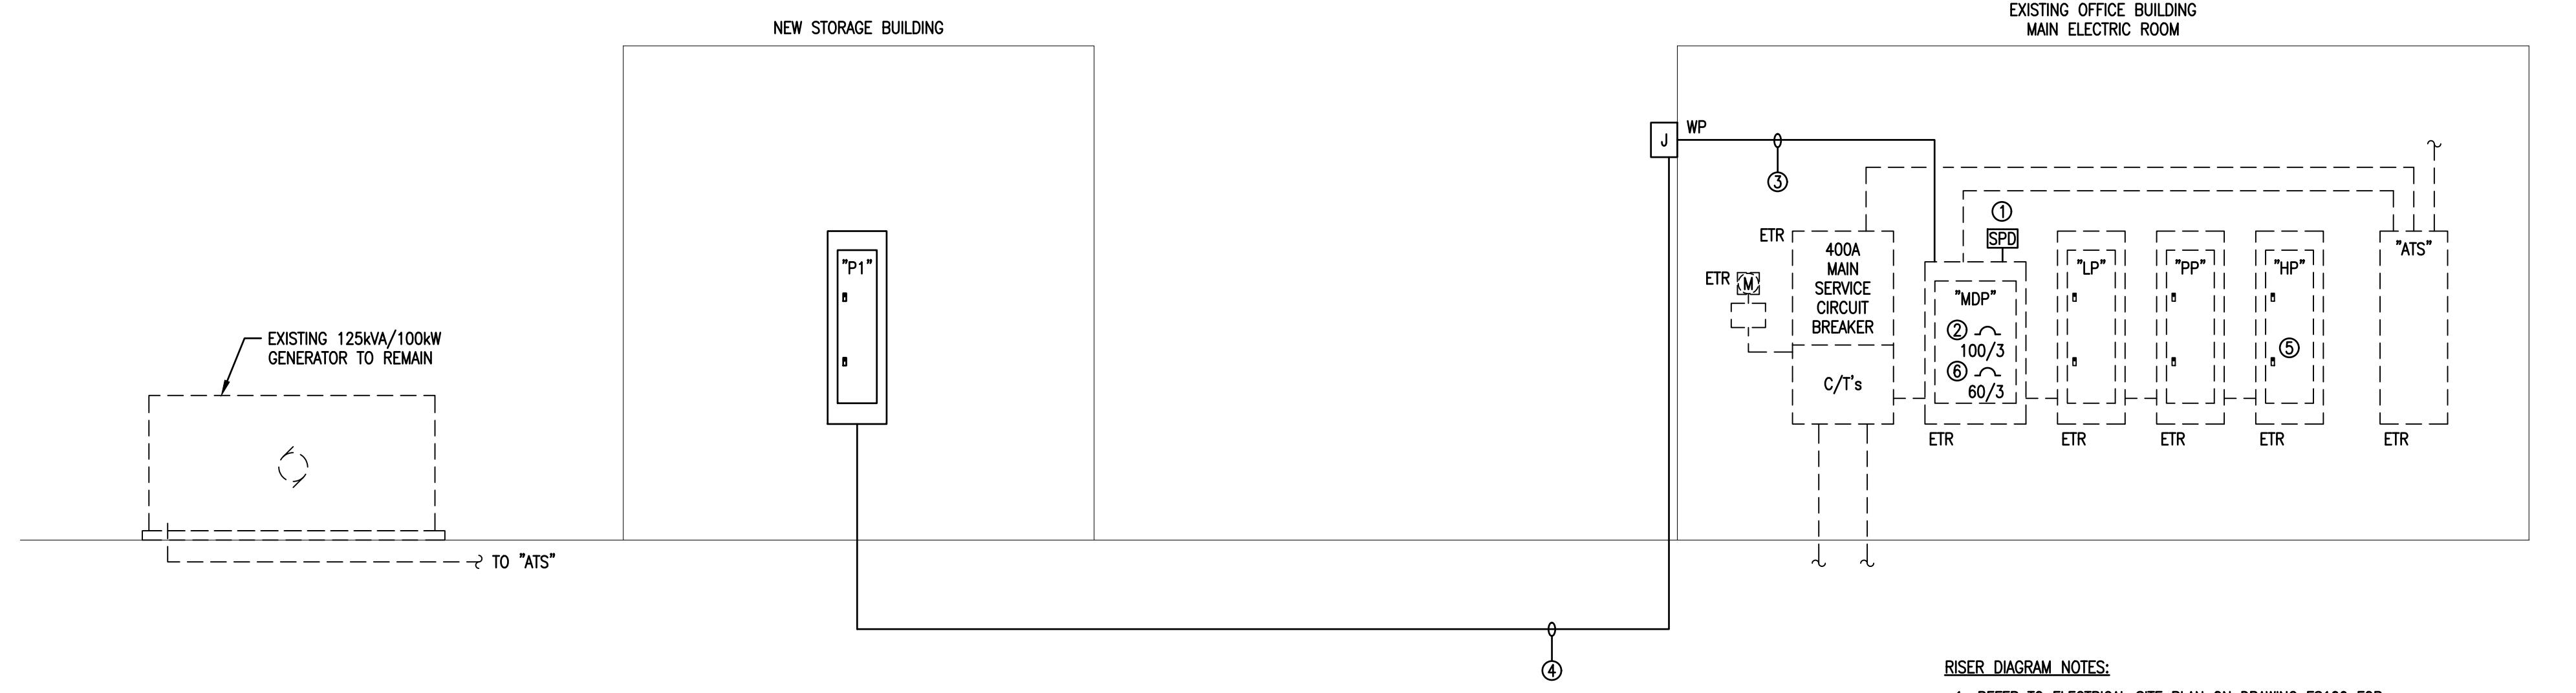

ELECTRIC RISER DIAGRAM

E300 Scale: NOT TO SCALE

RISER DIAGRAM NOTES:
1. REFER TO ELECTRICAL SITE PLAN ON DRAWING E5100 FOR
ADDITIONAL INFORMATION.
2. THE EXISTING ELECTRICAL SERVICE IS RATED 208Y/120V,
3-PHASE, 4-WIRE, 400-AMPS. THE EXISTING ELECTRIC MAIN
SERVICE CIRCUIT BREAKER AND PANELBOARDS "MDP", "LP", "PP",
AND "HP" ARE ALL MANUFACTURED BY FPE. ALL NEW CIRCUIT
BREAKERS AND EQUIPMENT PROVIDED UNDER THIS CONTRACT
SHALL BE 100% COMPATIBLE WITH THE EXISTING ELECTRICAL
EQUIPMENT AND SHALL MATCH THE EXISTING AMP RATINGS.

RISER DIAGRAM KEYED NOTES:
 ① PROVIDE SURGE PROTECTIVE DEVICE LISTED FOR USE ON SERVICE
ENTRANCE EQUAL TO DITEK #D200M-120/2083Y.
 ② PROVIDE (1) NEW 100A/SP CIRCUIT BREAKER AT EXISTING PANEL
"MDP" TO SERVE NEW STORAGE BUILDING PANELBOARD "P1".
 ③ PROVIDE 4#2, #80 IN 2" C. CONDUIT SHALL BE ROUTED THROUGH
ATTIC SPACE. REFER TO ELECTRICAL SITE PLAN ON DRAWING E5100
FOR ADDITIONAL INFORMATION.
 ④ PROVIDE 4#2, #80 IN 2" SCHEDULE 40 PVC CONDUIT. REFER TO
ELECTRICAL SITE PLAN ON DRAWING E5100 FOR ADDITIONAL
INFORMATION.
 ⑤ PROVIDE (1) NEW 20A/1P CIRCUIT BREAKER AT EXISTING PANEL
"HP". REFER TO ELECTRICAL SITE PLAN ON DRAWING E5100 FOR
ADDITIONAL INFORMATION. PROVIDE WITH EXTERNAL DEADFRONT GFCI
DEVICE EQUAL TO LEVITON #GFRBF-W.
 ⑥ PROVIDE (1) NEW 60A/SP CIRCUIT BREAKER AT EXISTING PANEL
"MDP" TO SERVE NEW SURGE PROTECTIVE DEVICE. PROVIDE
#6, #10G, 1-1/4".

CKT #	VOLT PHASE WIRE A.C. VERIFY	MAIN 100A MCB			100A MCB			MAIN BUS SEE RISER MOUNT SURFACE
		120/208	3	4	100A	100A	100A	
1	HIGHBAY LIGHTING - FRONT	530	20	1	20	1	180	2
3	HIGHBAY LIGHTING - REAR	539	20	1	20	1	540	4
5	STRIP LIGHTING	298	20	1	20	1	360	6
7	EXTERIOR LIGHTING	419	20	1	20	1	540	8
9		972	20	1	20	1	360	10
11	CEILING FAN BAF-1	972	15	3	20	1	432	12
13		972	20	1	20	1	7	14
15	CEILING FAN BAF-2	972	15	3	20	1	200	16
19		972	20	1	20	2	791	18
21	CEILING FAN CONTROLLER	200	20	1	20	1	80	20
23	MEZZANINE RECEPTACLES	360	20	1	20	1	600	22
25		864	20	1	20	1	432	24
27	OVERHEAD DOORS	864	15	3	20	1	SPARE	26
29		864	20	1	20	1	SPARE	28
31	OVERHEAD DOORS	864	15	3	20	1	SPARE	30
35		864	20	1	20	1	SPARE	32
37	SPARE		20	1	20	1	SPARE	34
39	SPARE		20	1	20	1	SPARE	36
41	SPARE		20	1	20	1	SPARE	38
							40	
							42	
		SUB-TOTALS			TOTAL PHASE A LOAD (W): 6,139			
		TOTAL PHASE B LOAD (W): 5,591			TOTAL PHASE C LOAD (W): 6,945			
		TOTAL CONNECTED LOAD (W): 18,675						

Drawn by SD
Checked by DC
Revised on 06/28/24
ADDENDUM #2




50 Holden Street
Providence, Rhode Island 02908
Phone: (401) 272-1730
Fax: (401) 273-1750
E-mail: rgber@rgber.com
www.rgber.com

Architecture • Project Management • Interior Design

Project

**DEDHAM-WESTWOOD
WATER DISTRICT**

**STORAGE
FACILITY**

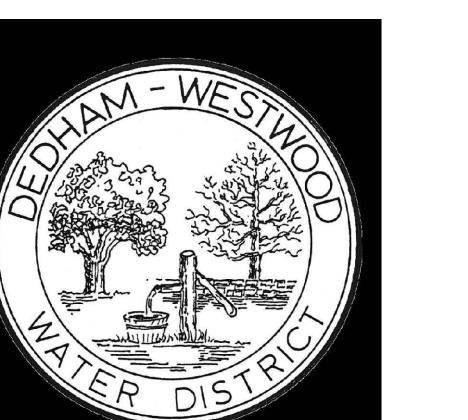

50 ELM STREET
DEDHAM, MA 02026

Drawing Status
100% CONSTRUCTION
DOCUMENTS

Issued On 5/24/2024

Sheet Contents

**ELECTRICAL RISER
DIAGRAM AND
PANELBOARD
SCHEDULE**

Project Number. 6790

Drawing No. E300

Sheet of

SECTION 00 04 10 - FORM FOR GENERAL BID MGL C.149 OVER \$150K

DATE:

TO THE AWARDING AUTHORITY: Dedham-Westwood Water District
50 Elm Street
Dedham, MA 02026

CARE OF: Mr. Blake Lukis, Executive Director

A. The Undersigned proposes to furnish all labor and materials required for renovations to the amenities building at Algonquin Regional High School located in Northborough, Massachusetts, in accordance with the accompanying plans and specifications prepared by RGB Architects for the contract price specified below, subject to additions and deductions according to the terms of the specifications.

B. This bid includes addenda numbered:

C. The proposed contract price is:

_____ dollars \$_____.
(Bid Amount in Words Bid Amount in Numbers)

For alternate No. _____ Add \$_____ Subtract \$_____

D. The subdivision of the proposed contract price is as follows:

ITEM 1. The work of the general contractor, being all work other than that covered by ITEM 2.

TOTAL OF ITEM 1 \$_____

Sub-trade Name of Filed Sub-bidder Sub-bid Amount Bond Required

Yes No (check one)

Sub-trade	Name of Filed Sub-bidder	Sub-bid Amount	Bond Required
-----------	--------------------------	----------------	---------------

TOTAL OF ITEM 2 \$

The undersigned agrees that each of the above named sub-bidders will be used for the work indicated at the amount stated, unless a substitution is made. The undersigned further agrees to pay the premiums for the performance and payment bonds furnished by sub-bidders as requested herein and that all of the cost of all such premiums is included in the amount set forth in ITEM 1 of this bid.

The undersigned agrees that if he is selected as general contractor, he will promptly confer with the awarding authority on the question of sub-bidders; and that the awarding authority may substitute for any sub-bid listed above a sub-bid filed with the awarding authority by another sub-bidder for the sub-trade against whose standing and ability the undersigned makes no objection; and that the undersigned will use all such finally selected sub-bidders at the amounts named in their respective sub-bids and be in every way as responsible for them and their work as if they had been originally named in this general bid, the total contract price being adjusted to conform thereto.

E. The undersigned agrees that, if he is selected as general contractor, he will within five days, Saturdays, Sundays and legal holidays excluded, after presentation thereof by the awarding authority, execute a contract in accordance with the terms of this bid and furnish a performance bond and also a labor and materials or payment bond, each of a surety company qualified to do business under the laws of the commonwealth and satisfactory to the awarding authority and each in the sum of the contract price, the premiums for which are to be paid by the general contractor and are included in the contract price; provided, however, that if there is more than 1 surety company, the surety companies shall be jointly and severally liable.

The undersigned hereby certifies that he is able to furnish labor that can work in harmony with all other elements of labor employed or to be employed on the work; that all employees to be employed at the worksite will have successfully completed a course in construction safety and health approved by the United States Occupational Safety and Health Administration that is at least 10 hours in duration at the time the employee begins work and who shall furnish documentation of successful completion of said course with the first certified payroll report for each employee; and that he will comply fully with all laws and regulations applicable to awards made subject to section 44A. The undersigned further certifies under the penalties of perjury that this bid is in all respects bona fide, fair and made without collusion or fraud with any other person. As used in this subsection the word "person" shall mean any natural person, joint venture, partnership, corporation or other business or legal entity.

The undersigned further certifies under penalty of perjury that the said undersigned is not presently debarred from doing public construction work in the commonwealth under the provisions of section

twenty-nine F of chapter twenty-nine, or any other applicable debarment provisions of any other chapter of the General Laws or any rule or regulation promulgated thereunder.

F. The undersigned agrees that the unit prices Work described under Division 01 22 00 UNIT PRICES are applicable for additional or deductive work from that as specified or shown on the Contract Documents. Include Section 01 22 00 with Bid Form.

NAME OF BIDDER

SIGNATURE AND TITLE OF PERSON SIGNING BID

Date: _____

BUSINESS ADDRESS

END OF SECTION 00 04 10

Bid Bond

CONTRACTOR:

(Name, legal status and address)

SURETY:

*(Name, legal status and principal place
of business)*

OWNER:

(Name, legal status and address)

BOND AMOUNT: \$**PROJECT:**

(Name, location or address, and Project number, if any)

The Contractor and Surety are bound to the Owner in the amount set forth above, for the payment of which the Contractor and Surety bind themselves, their heirs, executors, administrators, successors and assigns, jointly and severally, as provided herein. The conditions of this Bond are such that if the Owner accepts the bid of the Contractor within the time specified in the bid documents, or within such time period as may be agreed to by the Owner and Contractor, and the Contractor either (1) enters into a contract with the Owner in accordance with the terms of such bid, and gives such bond or bonds as may be specified in the bidding or Contract Documents, with a surety admitted in the jurisdiction of the Project and otherwise acceptable to the Owner, for the faithful performance of such Contract and for the prompt payment of labor and material furnished in the prosecution thereof; or (2) pays to the Owner the difference, not to exceed the amount of this Bond, between the amount specified in said bid and such larger amount for which the Owner may in good faith contract with another party to perform the work covered by said bid, then this obligation shall be null and void, otherwise to remain in full force and effect. The Surety hereby waives any notice of an agreement between the Owner and Contractor to extend the time in which the Owner may accept the bid. Waiver of notice by the Surety shall not apply to any extension exceeding sixty (60) days in the aggregate beyond the time for acceptance of bids specified in the bid documents, and the Owner and Contractor shall obtain the Surety's consent for an extension beyond sixty (60) days.

If this Bond is issued in connection with a subcontractor's bid to a Contractor, the term Contractor in this Bond shall be deemed to be Subcontractor and the term Owner shall be deemed to be Contractor.

When this Bond has been furnished to comply with a statutory or other legal requirement in the location of the Project, any provision in this Bond conflicting with said statutory or legal requirement shall be deemed deleted herefrom and provisions conforming to such statutory or other legal requirement shall be deemed incorporated herein. When so furnished, the intent is that this Bond shall be construed as a statutory bond and not as a common law bond.

Init.

Signed and sealed this day of ,

(Contractor as Principal)

(Seal)

(Witness)

(Title)

(Witness)

(Title)

(Surety)

(Seal)

Init.

AIA Document A310 – 2010. Copyright © 1963, 1970 and 2010. All rights reserved. "The American Institute of Architects," "American Institute of Architects," "AIA," the AIA Logo, and "AIA Contract Documents" are trademarks of The American Institute of Architects. This document was produced at 16:06:07 ET on 04/03/2024 under Order No.4104250106 which expires on 02/06/2025, is not for resale, is licensed for one-time use only, and may only be used in accordance with the AIA Contract Documents® Terms of Service. To report copyright violations, e-mail docinfo@aiacontracts.com.

/

User Notes:

(1852721529)

SECTION 08 36 00 - SECTIONAL OVERHEAD DOORS

PART 1 GENERAL

1.1 SECTION INCLUDES

- A. Insulated Sectional Overhead Doors.
- B. Electric Operators and Controls.
- C. Operating Hardware, tracks, and support.

1.2 RELATED SECTIONS

- A. Section 03300 - Cast-In-Place Concrete: Prepared opening in concrete. Execution requirements for placement of anchors in concrete wall construction.
- B. Section 05500 - Metal Fabrications: Steel frame and supports.
- C. Section 06114 - Wood Blocking and Curbing: Rough wood framing and blocking for door opening.
- D. Section 07900 - Joint Sealers: Perimeter sealant and backup materials.
- E. Section 08710 - Door Hardware: Cylinder locks.
- F. Section 09900 - Paints and Coatings: Field painting.
- G. Division 13 – Metal Building Systems
- H. Division 26 – Electrical for Raceway and Boxes: Empty conduit from control station to door operator.
- I. Division 26 – Electrical for Wiring Connections: Electrical service to door operator.

1.3 REFERENCES

- A. [ANSI/DASMA 102](#) - American National Standard Specifications for Sectional Overhead Type Doors.

1.4 DESIGN / PERFORMANCE REQUIREMENTS

- A. Wiring Connections: Requirements for electrical characteristics.
 - 1. 230 volts, three phase, 60 Hz.
- B. Single-Source Responsibility: Provide doors, tracks, motors, and accessories from one manufacturer for each type of door. Provide secondary components from source acceptable to manufacturer of primary components.

1.5 SUBMITTALS

- A. Submit under provisions of Section 01 30 00.
- B. Product Data: Manufacturer's data sheets on each product to be used, including:

1. Preparation instructions and recommendations.
2. Storage and handling requirements and recommendations.
3. Installation methods.

C. Shop Drawings: Indicate plans and elevations including opening dimensions and required tolerances, connection details, anchorage spacing, hardware locations, and installation details.

D. Manufacturer's Certificates: Certify products meet or exceed specified requirements.

E. Operation and Maintenance Data.

1.6 QUALITY ASSURANCE

- A. Manufacturer Qualifications: Company specializing in manufacturing products specified in this section with minimum five years documented experience.
- B. Installer Qualifications: Authorized representative of the manufacturer with minimum five years documented experience.
- C. Products Requiring Electrical Connection: Listed and classified by Underwriters Laboratories, Inc. acceptable to authority having jurisdiction as suitable for purpose specified.

1.7 DELIVERY, STORAGE, AND HANDLING

- A. Store products in manufacturer's unopened labeled packaging until ready for installation.
- B. Protect materials from exposure to moisture until ready for installation.
- C. Store materials in a dry, ventilated weathertight location.

1.8 PROJECT CONDITIONS

- A. Pre-Installation Conference: Convene a pre-installation conference just prior to commencement of field operations, to establish procedures to maintain optimum working conditions and to coordinate this work with related and adjacent work.

1.9 WARRANTY

- A. Warranty: Manufacturer's limited door warranty for 10 year against delamination of polyurethane foam from steel face and all other components for 1 year.
- B. Warranty: Manufacturer's limited door and operators System warranty for 10 year against delamination of polyurethane foam from steel face and all other components for 3 years or 20,000 cycles, whichever comes first.

PART 2 PRODUCTS

2.1 MANUFACTURERS

- A. Acceptable Manufacture: Overhead Door Corp., 2501 S. State Hwy. 121, Suite 200, Lewisville, TX 75067. ASD. Tel. Toll Free: (800) 275-3290. Phone: (469) 549-7100. Fax: (972) 906-1499. Web Site: www.overheaddoor.com. E-mail: sales@overheaddoor.com.
- B. Equivaleate products by the following manufactures may be submitted for approval:

1. Clopay Corporation; 8585 Duke Blvd Mason, OH, 45040-3100; website: <https://www.clopaydoor.com/> phone: 1-800-225-6729
2. Norco Industrial Doors; Norco Manufacturing, PO Box 246, Franksville, WI 53126; website: <https://norcom.com>; phone: (262) 835-2600
3. Wayne Dalton Wayne Dalton; 2501 S. State Highway 121 Business, Suite 200, Lewisville, TX 75067. ASD. Phone: (800) 827-3667; Web Site: www.wayne-dalton.com Email: info@wayne-dalton.com
4. Kelley Loading Dock Equipment, 1612 Hutton Drive, Suite 140 Carrollton, Texas 75006, email: kelly@4fronts.com, website: <https://kellydocksolutions.com/>; phone: 866-714-6679

C. Requests for substitutions will be considered in accordance with provisions of Section 016000.

2.2 INSULATED SECTIONAL OVERHEAD DOORS

A. Insulated Steel Sectional Overhead Doors: 592 Series Thermacore Insulated Steel Doors by Overhead Door Corporation. Units shall have the following characteristics:

1. Door Assembly: Metal/foam/metal sandwich panel construction, with PVC thermal break and weather-tight ship-lap design meeting joints.
- a. Panel Thickness: 2 inches (51 mm).
- b. Exterior Surface: Ribbed, textured.
- c. Exterior Steel: .015 inch (.38 mm), hot-dipped galvanized.
- d. End Stiles: 16 gauge with thermal break.
- e. Spring Counterbalance: Sized to weight of the door, with a helically wound, oil tempered torsion spring mounted on a steel shaft; cable drum of diecast aluminum with high strength galvanized aircraft cable. Sized with a minimum 7 to 1 safety factor.
 - 1) Standard cycle spring: 10,000 cycles.
- f. Insulation: CFC-free and HCFC-free polyurethane, fully encapsulated.
- g. Thermal Values: R-value of 17.50; U-value of 0.057.
- h. Air Infiltration: 0.08 cfm at 15 mph; 0.08 cfm at 25 mph.
- i. Pass-Door:
 - 1) Provide with optional pass door.
- j. High-Usage Package: Provide with optional high-usage package.
- k. Partial Glazing of Steel Panels:
 - 1) 1/2 inch (12.5 mm) Tempered Insulating glass.
2. Finish and Color:
 - a. Two coat baked-on polyester:
 - 1) Interior color: white
 - 2) Exterior color: Match adjacent insulated wall panel colors (white and red)
3. Windload Design: Provide to meet the Design/Performance requirements specified.
4. Hardware: Galvanized steel hinges and fixtures. Ball bearing rollers with hardened steel races.
5. Lock:
 - a. Keyed lock.
6. Weatherstripping:
 - a. EPDM bulb-type strip at bottom section.
 - b. Flexible Jamb seals.
 - c. Flexible Header seal.
7. Track: Provide track as recommended by manufacturer to suit loading required and clearances available.
 - a. Size: 3 inch (76 mm).
 - b. Type: Standard lift.
8. Manual Operation: Chain hoist.
9. Electric Motor Operation: Provide UL listed electric operator, size and type as recommended by manufacturer to move door in either direction at not less than 2/3

foot nor more than 1 foot per second. Operator shall meet UL325/2010 requirements for continuous monitoring of safety devices.

- a. Entrapment Protection: Required for momentary contact, includes radio control
 - 1) Photoelectric sensors monitored to meet UL 325/2010.
- b. Operator Controls:
 - 1) Push-button and key operated control stations with open, close, and stop buttons.
 - 2) Surface mounting.
 - 3) Both interior and exterior location.
- c. Special Operation:
 - 1) Vehicle detector operation.
 - 2) Door timer operation.

2.3 EXAMINATION

- A. Do not begin installation until openings have been properly prepared.
- B. Verify wall openings are ready to receive work and opening dimensions and tolerances are within specified limits.
- C. Verify electric power is available and of correct characteristics.
- D. If preparation is the responsibility of another installer, notify Architect of unsatisfactory preparation before proceeding.

2.4 PREPARATION

- A. Clean surfaces thoroughly prior to installation.
- B. Prepare surfaces using the methods recommended by the manufacturer for achieving the best result for the substrate under the project conditions.

2.5 INSTALLATION

- A. Install overhead doors and track in accordance with approved shop drawings and the manufacturer's printed instructions.
- B. Coordinate installation with adjacent work to ensure proper clearances and allow for maintenance.
- C. Anchor assembly to wall construction and building framing without distortion or stress.
- D. Securely brace door tracks suspended from structure. Secure tracks to structural members only.
- E. Fit and align door assembly including hardware.
- F. Coordinate installation of electrical service. Complete power and control wiring from disconnect to unit components.

2.6 CLEANING AND ADJUSTING

- A. Adjust door assembly to smooth operation and in full contact with weatherstripping.
- B. Clean doors, frames and glass.
- C. Remove temporary labels and visible markings.

2.7 PROTECTION

- A. Do not permit construction traffic through overhead door openings after adjustment and cleaning.
- B. Protect installed products until completion of project.
- C. Touch-up, damaged coatings and finishes and repair minor damage before Substantial Completion.

END OF SECTION 08 36 00

SECTION 32 31 23 - VINYL FENCING AND GATES

PART 1 - GENERAL

1.1 RELATED DOCUMENTS

- A. Drawings and general provisions of the Contract, including General and Supplementary Conditions and Division 01 Specification Sections, apply to this Section.

1.2 SUMMARY

- A. Section Includes
 - 1. Privacy Fence
 - 2. Post Caps
 - 3. Gates
 - 4. Gate Hardware

1.3 RELATED SECTIONS

- A. Section 03 30 00 - Cast-in-Place Concrete.

1.4 REFERENCES

- A. ASTM D 1784 - Standard Specification for Rigid Poly(Vinyl Chloride) (PVC) Compounds and Chlorinated Poly (Vinyl Chloride) (CPVC) Compounds.

1.5 DESIGN / PERFORMANCE REQUIREMENTS

- A. Provide fencing to meet applicable code requirements.

1.6 SUBMITTALS

- A. Product Data: Manufacturer's data sheets on each product to be used, including:
 - 1. Preparation instructions and recommendations.
 - 2. Storage and handling requirements and recommendations.
 - 3. Installation methods.
- B. Shop Drawings: Submit shop drawings for each product and accessory required. Include information not fully detailed in manufacturer's standard product data.
- C. Selection Samples: For each finish product specified, two complete sets of color chips representing manufacturer's full range of available colors and patterns.
- D. Verification Samples: For each finish product specified, two samples, minimum size 3 inches (76 mm) square, representing actual product, color, and patterns.
- E. Manufacturer's Certificates: Certify products meet or exceed specified requirements.

F. Closeout Submittals: Provide manufacturer's maintenance instructions that include recommendations for periodic cleaning and maintenance of all components.

1.7 QUALITY ASSURANCE

A. Manufacturer Qualifications: A firm engaged in the manufacture of vinyl fence and gates of types and sizes specified, and whose products have been in satisfactory use in similar service for a minimum of five years.

B. Installer Qualifications: A firm with a minimum of two years of successful installation experience with projects utilizing vinyl fence and gates similar in type and scope to that required for this Project.

C. Mock-Up: Provide a mock-up for evaluation of surface preparation techniques and application workmanship.

1. Finish areas designated by Architect.
2. Do not proceed with remaining work until workmanship, color, and sheen are approved by Architect.
3. Refinish mock-up area as required to produce acceptable work.
4. Accepted mock-ups shall be comparison standard for remaining Work

D. Pre-Installation Conference: Conduct pre-installation conference in accordance with Section 01 20 00 - Price and Payment Procedures. Date and time of the pre-installation conference shall be acceptable to the Owner and the Architect.

1. Prior to commencing the installation, meet at the Project site to review the material selections, installation procedures, and coordination with other trades.
2. Mock-ups shall be reviewed during the pre-installation conference.
3. Pre-installation conference shall include the Contractor, the Installer, and any trade that requires coordination with the work.

1.8 DELIVERY, STORAGE, AND HANDLING

A. Deliver materials to the Project site in manufacturer's original wrappings and containers, labeled with supplier's or manufacturer's name, material or product brand name, and lot number, if any.

B. Store materials in their original, undamaged packages and containers, inside a well-ventilated area protected from weather, moisture, soiling, extreme temperatures, and humidity.

1.9 SEQUENCING

A. Ensure that locating templates and other information required for installation of products of this section are furnished to affected trades in time to prevent interruption of construction progress.

B. Ensure that products of this section are supplied to affected trades in time to prevent interruption of construction progress.

1.10 PROJECT CONDITIONS

A. Maintain environmental conditions (temperature, humidity, and ventilation) within limits recommended by manufacturer for optimum results. Do not install products under environmental conditions outside manufacturer's absolute limits.

1.11 WARRANTY

A. Lifetime Limited, Non-Prorated Warranty on Material and 5 Year Prorated Labor Warranty.

PART 2 - PRODUCTS

2.1 MANUFACTURERS

A. Acceptable Manufacturer: Key-Link Fencing & Railing and Superior Plastic Products, which is located at: 260 Jalyn Dr.; New Holland, PA 17557; Toll Free Tel: 800-633-7093; Fax: 717-355-7129; Email:[request info \(jsurovi@superiorplastic.net\)](mailto:request info (jsurovi@superiorplastic.net)); <https://superiorplasticproducts.com>

B. Equivalent products by the following manufacturers may be submitted for approval:

1. Bufftech by Barrette Outdoor Living
2. Walpole Outdoors
3. National Vinyl Products

C. Requests for substitutions will be considered in accordance with provisions of Section 01 60 00.

2.2 MATERIALS

A. PVC: Poly Vinyl Chloride (PVC) formulated to resist impact and for Ultraviolet (UV) stabilization. Extruded products meets or exceeds ASTM D I784.

2.3 PRIVACY FENCE

A. Basis of Design: Hamilton Vinyl Privacy Fence

1. Height: 6 foot to match existing
2. Top and Bottom Horizontal Rails: 2 inch by 7 inch; verify to match existing
3. Vertical Panels: 3/4 inch by 10 inch interlocking; verify to match existing
4. Posts: 5 inch by 5 inch; verify to match existing
5. Gates and Posts: Matching fence style.
6. Colors: white

2.4 POST CAPS

1. Vinyl Post Cap
2. Size:5 inch New England; verify to match existing
3. Color: White

2.5 GATE HARDWARE

A. Gate Hardware: Stainless steel with aluminum latch clappers.

1. Aluminum Gate Handle.
2. Gate Wheel.
3. Aluminum Gate Brace.
4. Hinge Set
5. Commercial Latch: Stainless steel with aluminum latch clapper.
 - a. Drop Pin Kit - Commercial
6. Finish/Color: Powder coated
 - a. Black

PART 3 - EXECUTION

3.1 EXAMINATION

- A. Do not begin installation until conditions have been properly prepared.
- B. Verification of Conditions: Examine locations where fencing is to be installed for any conditions detrimental to the proper and timely completion of the work.
- C. If preparation is the responsibility of another installer, notify Architect of unsatisfactory preparation before proceeding.

3.2 PREPARATION

- A. Clean surfaces thoroughly prior to installation.
- B. Prepare the grade and remove surface irregularities, if any, which may cause interference with the installation of the fence.
- C. Prepare surfaces using the methods recommended by the manufacturer for achieving the best result for the substrate under the project conditions.

3.3 INSTALLATION

- A. Ins tall in accordance with manufacturer's instructions.
- B. Set posts and gate posts for gate openings as indicated on the Drawings.
- C. Center and align posts, place concrete around posts and vibrate or tamp for consolidation. Recheck vertical and top alignment of posts, and make necessary corrections.
- D. Install gates plumb, level, and secure for full opening without interference. For double gates, install drop rod. Adjust hardware for smooth operation.

3.4 CLEANING

- A. Touch-up, repair, or replace damaged products before Substantial Completion.
- B. Clean the work according to manufacturer's written instructions. Post hole excavations shall be scattered uniformly away from the posts. Clean fence with mild household detergent and rinse well with clean water. Remove mortar from exposed posts using a 10 percent solution of muriatic acid followed immediately by several rinses with clean water.

3.5 PROTECTION

- A. Protect installed products until completion of project.
- B. Touch-up, repair or replace damaged products before Substantial Completion.

END OF SECTION 32 31 23

Dedham-Westwood Water District
Storage Facility and Site Improvements

#6790 Dedham Westwood Water District Storage Facility and Site Improvements	
Plan Holder List	
#	Company Name
1	Ace Restoration Co. Inc.
2	AMI Boston Masonry/Restoration, Inc.
3	Araujo Bros Plumbing & Heating
4	AVCO Electric, Inc.
5	Beacon Building Supply
6	Beacon Waterproofing and Restoration
7	Brite-Lite Electrical Co., Inc.
8	CAM HVAC & CONSTRUCTION INC.
9	CDS Contracting Services, LLC
10	Cenedella Masonry Inc
11	Collins Construction
12	Commercial Masonry Corp.
13	Costa Brothers Masonry
14	Dagle Electrical Construction Corp
15	D&C Construction Co., Inc.
16	EJ Prescott
17	Empire Masonry Corp
18	Enterprise Equipment Co. Inc.
19	EV Mechanical INC
20	Fernandes Masonry
21	G&H Heating and Cooling, llc
22	Glionna Plumbing & Heating Services, Inc
23	G.V.W., Inc
24	GenCon Construction
25	Jandris Block
26	JJ Cardosi Inc
27	Kneeland Plumbing & Heating, Inc.
28	L & L Contracting, Inc.
29	IaPan mechanical
30	Marmelo Bros Construction
31	MRCSolutions LLC
32	M-V Electrical Contractors, Inc.
33	Nadeau Corporation
34	Needham Certified Welding Corp.
35	New England Specialty Services Inc.
36	Northern Contracting Corp
37	Performance Plumbing & Heating
38	PJ Dionne Company, Inc
39	Quinn Bros. of Essex, Inc.
40	Robert W. Irvine & Sons, Inc.
41	Seaver Construction
42	South Coast Improvement Company
43	SYSTEMS CONTRACTING INC
44	TCD Construction
45	TerraCalc
46	Tower Construction
47	United Steel, Inc
48	Vantage Builders
49	Veterans Development Corporation, Inc.
50	VG Iron
51	Wayne J. Griffin Electric, Inc.
52	WCI Corp.

Dedham-Westwood Water District
Storage Facility and Site Improvements

53	WES Construction Corp.
54	Willke The Waterproofing Company LLC
55	V & G Iron Works, Inc
56	Vantage Builders